

Sec. 14 Twp. 11 R. 18W ✓

Well No. #1 Lynon Farm

H. H. Blair Company

Contractor


330' Ft. from N. Line

Ft. from S. Line

Ft. from E. Line

330' Ft. from W. Line

NW NW SW

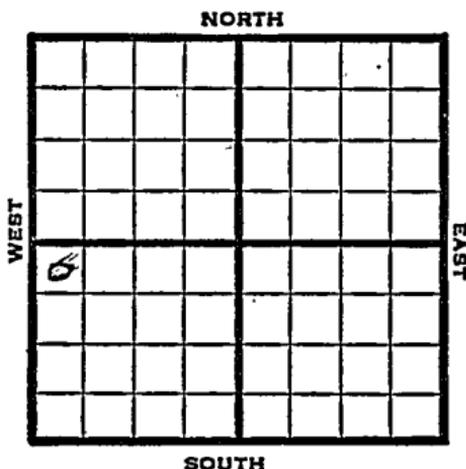

1950

Elev 1880

REPORT

5/24 Location

6/21 TD 3480

10" @ 120

Anhy 1178-1215

Heeb 3090

Lans 3128

DST 3164-74 opn 30 min rec 20' mud

B KC 3361

Cong 3387

Simp 3423

Arb 3465

D&A

ABANDONED

Map No. _____ Sec. 14 Twp. 11 R. 18W

Well No. 1 Lyon

H. H. Blair Company

Contractor

NW NT SW

SECTION PLAT

330 Ft. from N. Line

_____ Ft. from S. Line

_____ Ft. from E. Line

330 Ft. from W. Line

	FIRST	REPORT	
o			

Ellis

Location X

Rig up _____

Drilling and Remarks:

RECORD

Cased _____ in., _____ ft.

Sand _____

Gas _____

Oil _____

Total Depth _____

PRODUCTION

1st 24 hrs. Nat. _____

1st 24 hrs. after shot _____

Gas _____ Cu. Ft.

Dry Hole _____

Abandoned _____

Date

MAY 24 1950 19

J. E. TYRA

Scout

Map No. _____ Sec. 14 Twp. 11 R. 18W

Well No. 1 Lynn

H. H. Blair Company

Contractor

NW NW SW

E1. 1880
SECTION PLAT

330 Ft. from N. Line

_____ Ft. from S. Line

_____ Ft. from E. Line

330 Ft. from W. Line



Ellis County

Location _____

Rig up _____

Drilling and Remarks:

10" @ 120

Anhy 1178-1215

Heeb. 3090

Lans. 3128

DST 3164-74

open 30 min.

Rec. 20' mud

RECORD

Cased _____ in., _____ ft.

Sand _____

Gas _____

Oil _____

Total Depth 3480

PRODUCTION

1st 24 hrs. Nat. _____

1st 24 hrs. after shot _____

Gas _____ Cu. Ft.

Dry Hole _____

Abandoned _____

Date

JUN 21 1950 19

J. E. TYRA Scout

