

KANSAS

FORM 51 5M 10-41 PETROL


Ellis

Section 14 Township 11 Range 18-W

Well No. #1 Lynn

Company Nadel & Gussman

NORTH Walters Pool

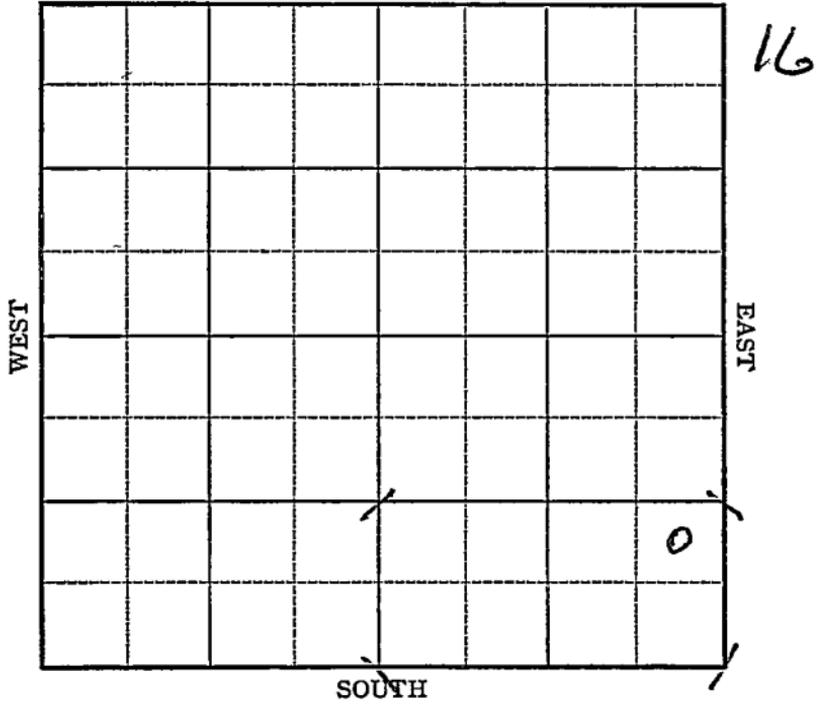

Map No. 71 Sec. 14 Twp. 11 R. 18W

Ellis

Well No. 1 Lynn

Nadel & Gusman Company

COMPLETED

Contractor

NE SE SE

SECTION PLAT

			o

_____ Ft. from N. Line
990 Ft. from S. Line
330 Ft. from E. Line
 _____ Ft. from W. Line

WALTERS POOL

Location _____

Rig up _____

Drilling and Remarks:

Cell 3453
5" @ 3454
1500 acid
Dep. H. B. 1451

28 1/2 hr

RECORD

Cased _____ in., _____ ft.
 Sand _____
 Gas _____
 Oil _____
 Total Depth 3470

PRODUCTION

1st 24 hrs. Nat. _____
 1st 24 hrs. after shot _____
 Gas _____ Cu. Ft.
 Dry Hole _____
 Abandoned _____

Date

APR 22 1942 19

S. J. LEWIS Scout