

DX 78-1

Ellis

KANSAS

Section 14 Township 11 S Range 19 W

Well No. # 1 Richards Est.

Company Frontier Oil Co.

NORTH

						0	

SOUTH

Ellis KANSAS


SEC.	TWP.	R.
14	11S	19W

WELL NO. I Richards Est. FARM

COMPANY Frontier Oil Co.

CONTRACTOR Jones, Shelburne-Farmer
Solomon

_____ Ft. from N. Line
330 _____ Ft. from S. Line
990 _____ Ft. from E. Line
_____ Ft. from W. Line

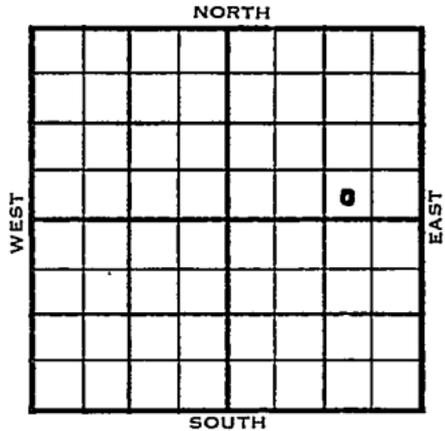

SW SE NE
Sunray FO

	ELEVATION	REPORT
1954	1929'	
12/8		Spud 12-4-54 8" @ 164' w/150 sks D rlg. 2218'
12/22		Spud 12-4-54 D & A TD 3476' 8" @ 164' Heeb 3128' Lans 3166' Arb. 3471' DST 3471'-76' opn 1 1/2 hr, rec 240' ho 360' s.w. 950# TD 3476' D & A

ABANDONED

County Ellis State Kansas

Sec. 14 (Blk.) 31S (Sur.) 19W Map No.

Operator Frontier Oil Co.

Well No. 1 Farm Richards Est.

Elev. _____ Location SW SE NE

330 Ft. From S Line

990 Ft. From E Line NE Quarter

Ist. Report DEC 8 1954

Completion _____

Remarks Jones, Shelburne - Far-

Sunray NO mer

Spudding Date 12-4-54

Drlg. Data Solomon

8" @ 164 w/150, Drlg. 2218

