


Section 14 Township 11 Range 19W

Well No. #3 Vine

Company Continental

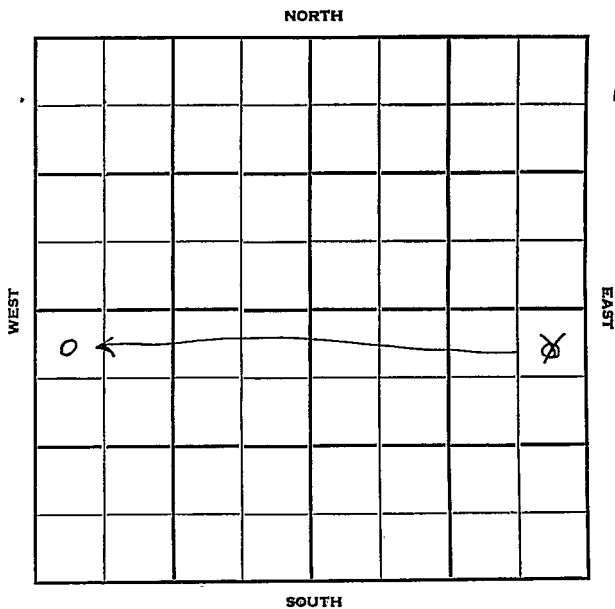

Ellis

KANSAS

Sec. 14 Twp. 11 R. 19 W ✓

Well No. # 3 Vine Farm

Continental Company

Contractor

330 Ft. from N. Line


Ft. from S. Line

330 Ft. from E. Line

330 Ft. from W. Line

~~NE NE SE~~

NW NW SW

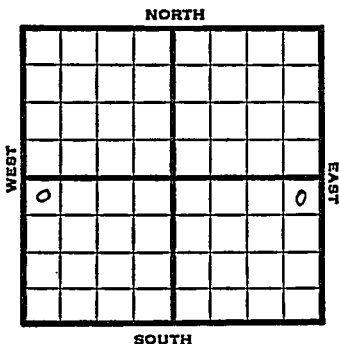

1951 Elev. 1964' REPORT

10/10 Spud 10-9-51  
13" @ ?

11/7 Spud 10-9-51  
Oil Well TD 3497  
13" @ 140  
Anhy 1270  
8" @ 1279  
Heeb. 3138  
Cong. 3411  
Arb. 3484  
TD 3486 5" @ 3485  
CO to 3490 S/ 2 1/2 BOPH  
DD 3494 S/ 4 BOPH  
Comp. 178 BOPD

Ians. 3178  
Simp. 3467

**COMPLETED**

County Ellis State Kansas

Sec. 14 (Blk. II) (Sur. 19W) (Twp. II) (Rge. 19W) Map No.

Operator Continental

Well No. 3 Farm Vine

Elev. \_\_\_\_\_ Location NE NE SE

FIRST REPORT							
							●

330 Ft. From N Line SE

330 Ft. From E Line Quarter

Ist. Report OCT 10 1951

Completion \_\_\_\_\_

Remarks \_\_\_\_\_

Spudding Date 10-9-51

Drlg. Data \_\_\_\_\_

13<sup>th</sup> @ \_\_\_\_\_

J. E. TYRA

Map No. \_\_\_\_\_ Sec. 14 Twp. 11 R. 19W

Well No. 3 Vine

Continental Company

**CORRECTION**

Contractor

NW NW SW

**SECTION PLAT**

330 Ft. from N. Line

\_\_\_\_\_ Ft. from S. Line

\_\_\_\_\_ Ft. from E. Line

330 Ft. from W. Line

o			

Ellis County

**RECORD**

Location \_\_\_\_\_

Cased \_\_\_\_\_ in., \_\_\_\_\_ ft.

Rig up \_\_\_\_\_

Sand \_\_\_\_\_

Drilling and Remarks:

Gas \_\_\_\_\_

Oil \_\_\_\_\_

Total Depth \_\_\_\_\_

Reported

NE NE SE

**PRODUCTION**

1st 24 hrs. Nat. \_\_\_\_\_

1st 24 hrs. after shot \_\_\_\_\_

Gas \_\_\_\_\_ Cu. Ft.

Dry Hole \_\_\_\_\_

Abandoned \_\_\_\_\_

Date

OCT 24 1951 19

J. E. TYRA Scout

County Ellis State Kansas

Sec. 14 (Blk. Twp.) 11 (Sur. Rge.) 19W Map No.

Operator Continental Oil

Well No. 3 Farm Vine

Elev. 1964 Location NW NW SW


330 Ft. From N Line SW

330 Ft. From W Line, Quarter

Ist. Report

Completion NOV 7 1951

Remarks Solomon Pool

Spudding Date 10-9-51

Drlg. Data Oil well TD 3497

13" @ 140 Anhy 1270 8" @ 1279

Heeb. 3138 Lans. 3178. Cong. 3411

Simp. 3467 Arb. 3484 TD 3486 5" @ 3485

CO to 3490 S/ 2 1/2 boph DD 3494 S/ 3 boph

DD 3497 S/ 3 boph 500 A S/ 4 boph

Comp. 178 bopd

J. E. TYRA