


DX 78-1

Section 14 Township 11 Range 21W

Well No. #1 J. W. Nicholson

Company Continental Oil

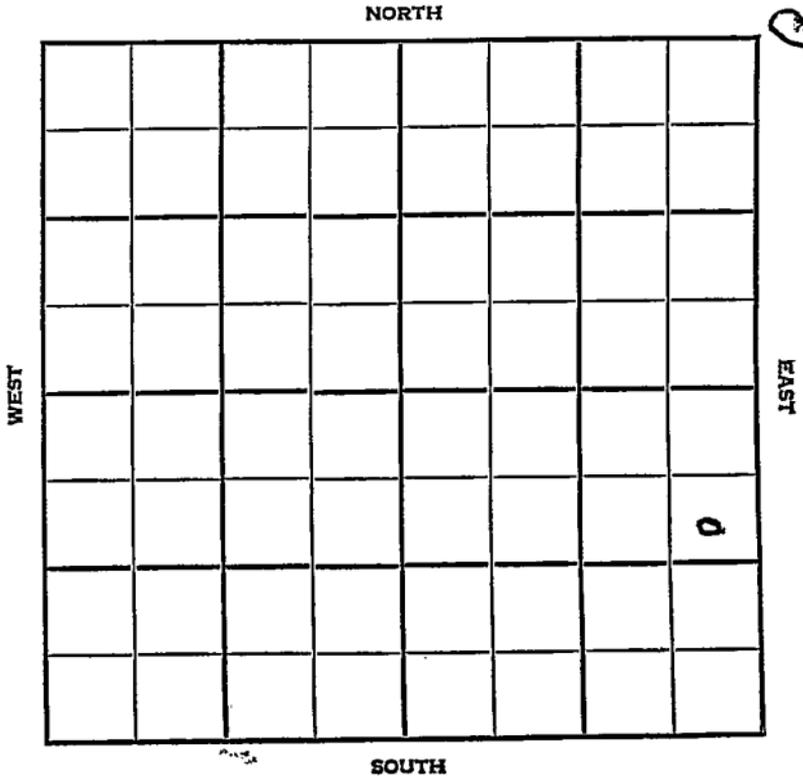

Trego KANSAS

SEC: 14	TWP. 11	R. 21W
------------	------------	-----------

WELL NO. 1 J. W. Nicholson FARM

COMPANY Continental Oil

CONTRACTOR Garvey


Walz Pool

990 Ft. from N. Line

Ft. from S. Line

330 Ft. from E. Line

Ft. from W. Line

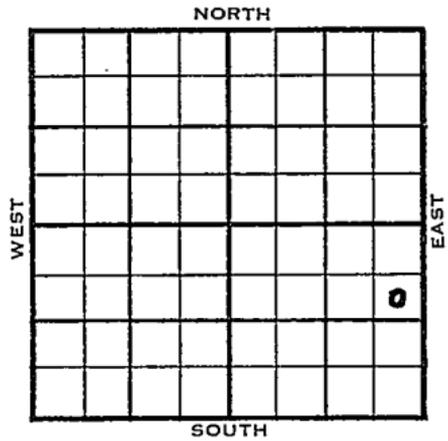

SE NE SE

	ELEVATION	REPORT
1955	2161'	

4/6 Location
 4/27 Spud 4-10-55
 D & A
 TD 3822'
 8" @ 220'
 Heb. 3406', Lans. 3446', Gong. 3730'
 DST 3730'-40' opn 1 hr, rec 15' Mud
 O# Arb. 3792'
 TD 3822'
 Tor. 3428', B KC 3677'
 D & A

ABANDONED

