


Jugo

Form 51-5M-11-31-Palace

Map No. **KANSAS** Sec. *14* Twp. *11* R. *23^W*

Well No. *1 Rhodes East* Farm
Alma Pet & Mc Neely Company

NORTH

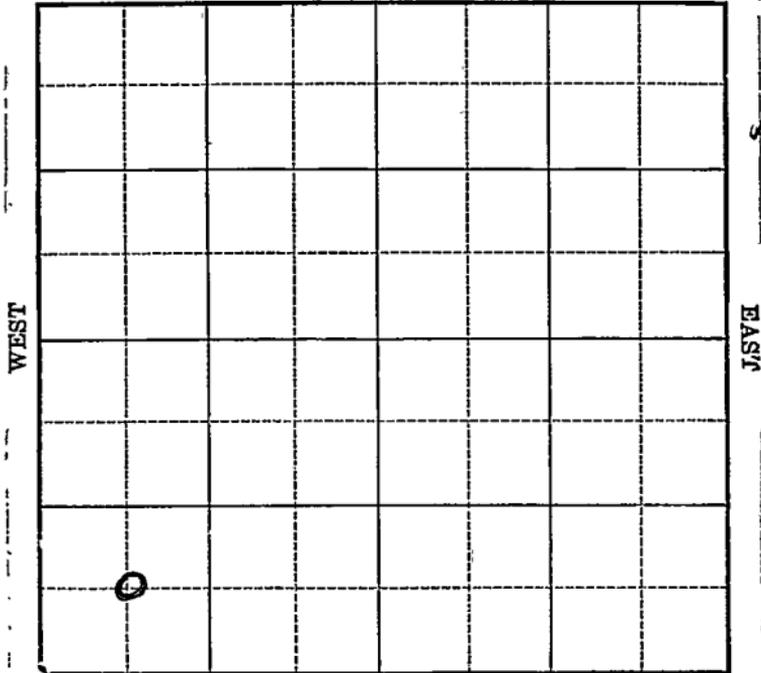

SOUTH

Location _____

Drilling Remarks _____

Rig Up _____

Drilling Remarks _____

RECORD

Cased _____ in. _____ ft.

Sand _____

Gas _____

Oil _____

Total Depth _____

PRODUCTION

1st 24 hrs. Nat. _____

1st 24 hrs. after shot _____

Gas _____ cu. ft.

Dry Hole _____

Abandoned _____

Trego

Map No. **KANSAS** Sec. *14* Twp. *11* R. *23W*

Well No. *1 Rhodes East* Farm


Alma Pet & Mc Neely Company

_____ Ft. from N. Line

660 Ft. from S. Line

_____ Ft. from E. Line

660 Ft. from W. Line

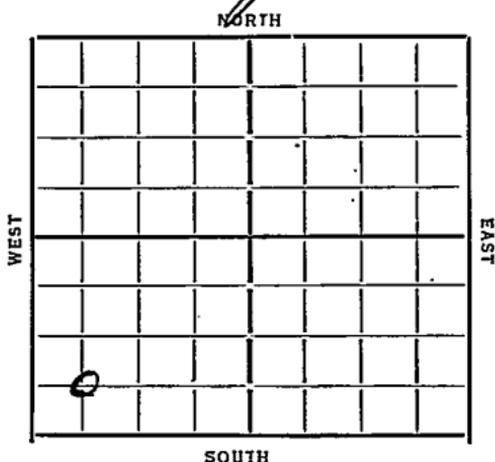

Date *1934*


REPORT

Date	Description
<i>3/21</i>	<i>Location</i>
<i>3/29</i>	<i>— 4/5 —</i>
<i>4/12</i>	<i>15" 144</i>
<i>4/19</i>	<i>dlg 1435</i>
<i>4/26</i>	<i>" 2415</i>
<i>5/3</i>	<i>" 2845</i>
<i>5/10</i>	<i>" 3360</i>
<i>5/18</i>	<i>Oswald 3552 8" 3558</i>
	<i>TD 3593 Rust</i>
<i>5/25</i>	<i>—</i>
<i>5/31</i>	<i>Show oil 3578-3592</i>
	<i>More oil 3619-20 2/7/34 3624</i>
<i>6/7</i>	<i>6" 3700 c.o.</i>
<i>6/14</i>	<i>dlg 3828</i>
<i>6/21</i>	<i>W.C. 6" 3860</i>
<i>6/28</i>	<i>Comp 3885 6" 3860 7 sq.</i>
<i>7/5</i>	<i>Comp 3870 TD 3885</i>
	<i>6" 3860 s.o. 3910</i>
<i>7/12</i>	<i>6" 3935 T Oil 3978</i>
	<i>TD 4020 Rep. Rig</i>
<i>7/19</i>	<i>4105 7 sq. hole</i>
<i>7/26</i>	<i>dlg 4200</i>

Map No. _____ Sec. 14 Twp. 11 R. 23^w

Well No. 1 Rhodes Est Farm
Alma Pet & Mc Neely Company

NORTH

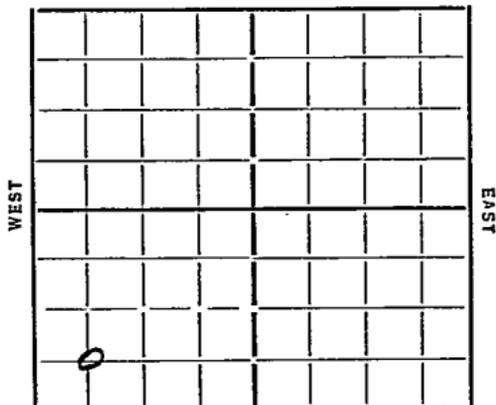

SOUTH

_____ Ft. from N. Line

660 Ft. from S. Line

_____ Ft. from E. Line

660 Ft. from W. Line

Date 1934

REPORT

8/2 4222 TD PB 3610
8/9 PB 3605 Acost 150 Bbls fluid
 30 Bbls oil
8/16 PB 3620 from 3639 acidizing
8/23 _____
8/30 Pump 130 Bbls oil & 200 water
 24 hrs.
9/5 T Siliceous 3978 TD 4222
 PB 3595 T Oswald 3552
 1000 acid 120 oil 20 water.

COMPLETED

Map No. 69 Sec. 14 Twp. 11 R. 23W

Well No. 1 - Rhodes Est

Alma pit. & McNeely Company

Contractor

FIRST REPORTS

SECTION PLAT

0			

Ft. from N. Line

660

Ft. from S. Line

Ft. from E. Line

660

Ft. from W. Line

Location

Rig up

Drilling and Remarks:

RECORD

Cased in. ft.

Sand

Gas

Oil

Total Depth

PRODUCTION

1st 24 hrs. Nat.

1st 24 hrs. after shot

Gas Cu. Ft.

Dry Hole

Abandoned

Date

3/21/34

192

O. Munnick Scout

Map No. 69 Sec. 14 Twp. 11 R. 23W

Well No. 1 - Rhodes est

Alma Pitt + M. Neely Company

Contractor

COMPLETED

SECTION PLAT

0			

 Ft. from N. Line

660 Ft. from S. Line

 Ft. from E. Line

660 Ft. from W. Line

Location

Rig up

Drilling and Remarks:

P. B. 3595
Top of well 3552
1000 acid
120 oil
20 water

RECORD

Cased in., ft.

Sand 3978

Gas

Oil

Total Depth 4222

PRODUCTION

1st 24 hrs. Nat.

1st 24 hrs. after shot

Gas Cu. Ft.

Dry Hole

Abandoned

Date

9-5-37 1937

Scout

ORVAL MANNSCHECK