

DX 78-1

Trego


KANSAS

Section 14 Township 11 Range 23 W

Well No. # 1 Rhoades "B"

Company Petroleum Inc.

NORTH

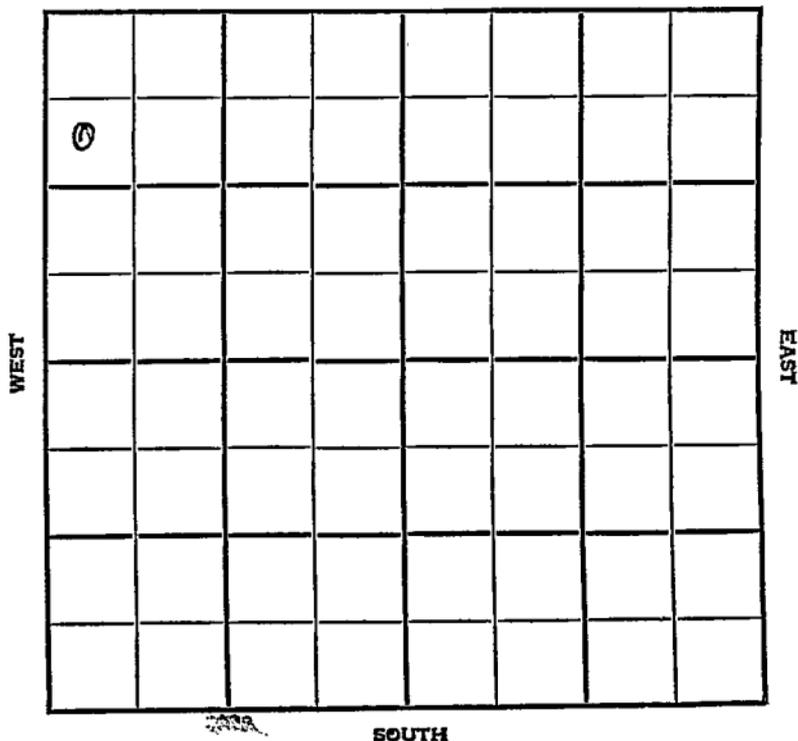

SOUTH

Trego

KANSAS

SEC.	TWP.	R.
14	11	23W

WELL NO. #1 Rhoades "B" FARM

COMPANY Petroleum Inc.


CONTRACTOR Co. Tools.

Wakeeney Pool
990 Ft. from N. Line

Ft. from S. Line

Ft. from E. Line

330 Ft. from W. Line

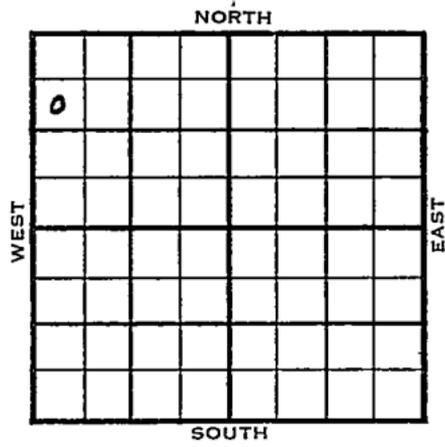

SW NW NW

	ELEVATION	REPORT
1954	2253'	

12/1 Spud 11-24-54
8" @ 206'

1955
2/2 Spud 11-24-54
TITE HOLE.
8" @ 206'
TD 3973'
D & A

ABANDONED

County Trego State Kansas

Sec. 14 (Blk. Twp.) 11 (Sur. Rge.) 23W Map No.

Operator Petroleum Inc.

Well No. 1 Farm Rhoades "B"

Elev. 2253 Location SW NW NW

0					

990 Ft. From N Line NW

330 Ft. From W Line Quarter

1st. Report

FEB 2 1955

Completion

Remarks Wakeeney Pool

Co. tools

Spudding Date 11-24-54

Drlg. Data TITE HOLE

.8" @ 206 TD 3973 D & A

FABEN GILSTRAP