




Grego  
23W

Map No. KANSAS Sec. 14 Twp. 11 R. 23W

Well No. 2 - Rhodes Estate Farm  
Alva Pit & Mc. Nealey Company

660 Ft. from N. Line  
\_\_\_\_ Ft. from S. Line  
\_\_\_\_ Ft. from E. Line  
660 Ft. from W. Line

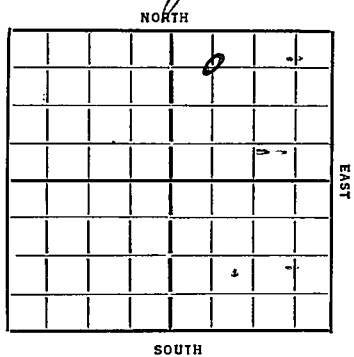

Elev. 2211

Date	REPORT
12/14	Ran up Rotary
12/19	dy 1658 12" 118
12/26	" 2725
1/2/36	Rest
1/10	Top Aubey 1705 7" 3450 TD 3452 Bailing
1/17	Top Lams. 3450 TD 3519 6" 3452 350' OTH 2000 acid
1/24	TD 3519 Awaiting 60 Bbls Oil & 75 Bbls water per day
1/31	TD 3525 holed 54' in 16 hrs test
2/7	pumped 40 to 50 Bbls per day
2/14	Installing pumping unit - 2/21 -
2/28	Est 45 Bbls per day to deepen ssho wtr
3/6	TD 3531 1750' fluid Bailing
3/9	Est 50 Bbls per day (over)

- 3/20 HFW 3538-41 T.D. 3563 Plugging back to 3563.
- 3/27 Plugged back 3520 Pumping water.
- 4/2- Pumping 10 bbls oil and 20 bbls. ~~and~~ water per day.
- 4/10--
- 4/16- 2000 gallons acid. No test.
- 4/23- S.D.
- 4/30-- 5/7--5/14--
  
- 5/20/36- Lansing 3450'.  
 P.B. 3520'.  
 2000 acid.  
 T.D. 3531'.  
 Pump 70 bbls.

COMPLETED



Map No. 69 Sec. 14 Twp. 11 R. 23 WWell No. 2 Rhodes EstateAlma P. & M. Kealey Company

Contractor

## SECTION PLAT

		0	

660 Ft. from N. Line

\_\_\_\_\_ Ft. from S. Line

\_\_\_\_\_ Ft. from E. Line

660 Ft. from W. Line

COMPLETED

Location \_\_\_\_\_

Rig up \_\_\_\_\_

Drilling and Remarks:

Leasing 3450P.B. 35202000 acidPump 90 & 1/2 h.

## RECORD

Cased \_\_\_\_\_ in., \_\_\_\_\_ ft.

Sand \_\_\_\_\_

Gas \_\_\_\_\_

Oil \_\_\_\_\_

Total Depth 3531

## PRODUCTION

1st 24 hrs. Nat. \_\_\_\_\_

1st 24 hrs. after shot \_\_\_\_\_

Gas \_\_\_\_\_ Cu. Ft.

Dry Hole \_\_\_\_\_

Abandoned \_\_\_\_\_

Date

MAY 20 1936

19

S. J. LEWIS

Scout