

KANSAS


Trego

FORM 51 5M 10-41 PETROL

Section 14 Township 11 Range 23-W

Well No. #3 Rhoades Estate

Company Watchorn Oil & Gas etal

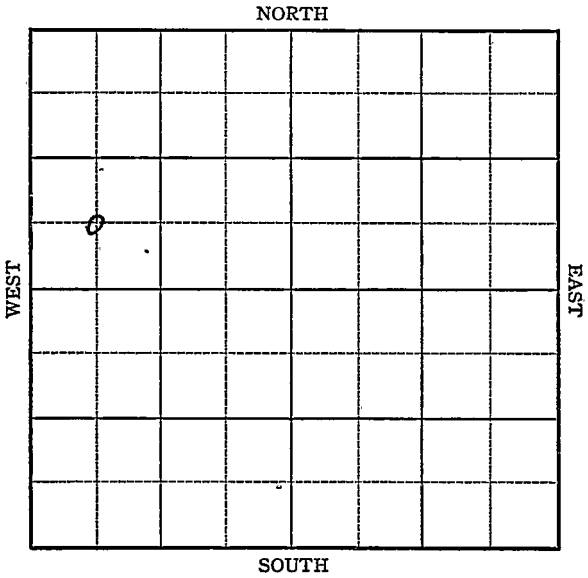

Sec. 14 Twp. 11 R. 23-W

Well No. #3 Rhoades Estate Farm

Watchorn Oil & Gas etal. Company


Miscellaneous

_____ Ft. from N. Line

660 Ft. from S. Line

_____ Ft. from E. Line

660 Ft. from W. Line

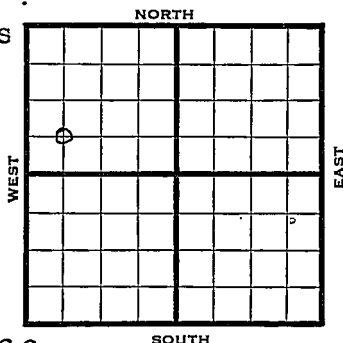

C SW NW *Elev. 2288*

1942

REPORT

12/22 Drlg. 3180'

12/29 Fishing 3180

1943

1/6 12" Casing set at 75'

Arb 3995

Drlg. 4085'

1/13

Anhy 1750

Lans 3522

Arb 3982 corrected

7" casing set 3700'

1/20

T.D. 4075' RUST

7" Casing set 3734' Corrected

Plug 3704' SD.

1/27

" " "

2/3

12 shots 3628-32

100' oil 800' water in 2 hrs.

P.B. 3622'

12 shots 3570-78'

1435' water in 14 hrs. to set another plug.

2/10

12 shots 3628-42 SW

19 " 3576-88 SW

8 " 3548-51 SW squeeze off perf.

19 " 3624-29 SW Trace oil.

2/17

1000 acid increase water SD.

2/23

Arb. 3982'

7" @ 3734'

T.D. 4075' Water

ABANDONED

KANSAS
 Map No. 69 Sec. 14 Twp. 11 R. 23W

Well No. 3 Rhoades Estate

Watchorn Oil & Gas et al. Company

FIRST REPORT Contractor

C SW NW

SECTION PLAT

_____ Ft. from N. Line

660 Ft. from S. Line

_____ Ft. from E. Line

660 Ft. from W. Line

o			

MISCELLANEOUS

Location _____

Rig up _____

Drilling and Remarks:

Drlg. 3180'

RECORD

Cased _____ in., _____ ft.

Sand _____

Gas _____

Oil _____

Total Depth _____

PRODUCTION

1st 24 hrs. Nat. _____

1st 24 hrs. after shot _____

Gas _____ Cu. Ft.

Dry Hole _____

Abandoned _____

Date

DEC 22 1942 19

S. J. LEWIS Scout

KANSAS Tre go

Map No. 69 Sec. 14 Twp. 11 R. 23WWell No. 3 Rhoades EstateWatchorn Oil & Gas etal Company

ABANDONED

Contractor

C SW NW

 Ft. from N. Line660 Ft. from S. Line Ft. from E. Line660 Ft. from W. Line

SECTION PLAT

o			

MISCELLANEOUS

Location Rig up

Drilling and Remarks:

Co. X 3982.2" @ 3984Water

RECORD

Cased in., ft.Sand Gas Oil Total Depth 4075

PRODUCTION

1st 24 hrs. Nat. 1st 24 hrs. after shot Gas Cu. Ft.Dry Hole Abandoned

Date

FEB 24 1943

19

S. I. LEWIS Scout