


Section 14 Township 11 Range 17-W

Well No. 1 - Hall

Company Empire

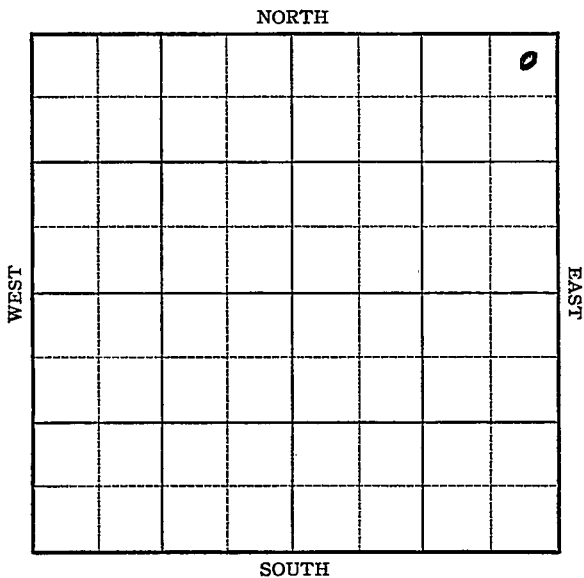

Sec. 14 Twp. 11 R. 17-W

Well No. #1 Hall Farm

Empire Company


330 Ft. from N. Line

_____ Ft. from S. Line

330 Ft. from E. Line

_____ Ft. from W. Line

Elev. 1809

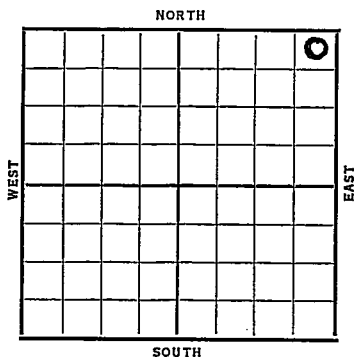

Date	REPORT
1937	
6/16	B.R.R.
6/25	R U R
7/2	15" @ 180'. Drlg. 1020'.
7/9	Anhy 1015'. 10" @ 1020'.
	Drlg. 1648'.
7/16	Drlg. 2710'.
7/23	Topeka 2760'. K.C. 3039'.
	Drlg. 3139'.
7/30	Cong. 3310'. Simp. 3385'.
	Sil. 3406'. T.D. 3420'.
	Rng. Haliburton test.
8/4	Sil 3406'
	TD 3420'
	D&A
	ABANDONED

Ellis **KANSAS**

Map No. 71 Sec. 14 Twp. 11 R. 17^W

Well No. 1 - Hall

Empire Company

Contractor

FIRST REPORT

SECTION PLAT

330 Ft. from N. Line

_____ Ft. from S. Line

330 Ft. from E. Line

_____ Ft. from W. Line

			2

Location _____

Rig up _____

Drilling and Remarks:

B.R.R.

RECORD

Cased _____ in., _____ ft.

Sand _____

Gas _____

Oil _____

Total Depth _____

PRODUCTION

1st 24 hrs. Nat. _____

1st 24 hrs. after shot _____

Gas _____ Cu. Ft.

Dry Hole _____

Abandoned _____

Date

JUN 16 1927

H. D. Hatfield Scout

Ellis **KANSAS**Map No. _____ Sec. 14 Twp. 11 R. 17^wWell No. 1 - HallEmpire Company

Contractor

ABANDONED

SECTION PLAT

330 Ft. from N. Line

_____ Ft. from S. Line

330 Ft. from E. Line

_____ Ft. from W. Line

			0

Location _____

Rig up _____

Drilling and Remarks:

D & A

RECORD

Cased _____ in., _____ ft.

Sand Sil 3406

Gas _____

Oil _____

Total Depth 3420

PRODUCTION

1st 24 hrs. Nat. _____

1st 24 hrs. after shot _____

Gas _____ Cu. Ft.

Dry Hole _____

Abandoned _____

Date

AUG 4 - 1937 19

H. D. Hatfield

Scout

1937