


DX 78-1

Section 14 Township 11 Range 17W

Well No. 1 Hall


Company Derby Oil

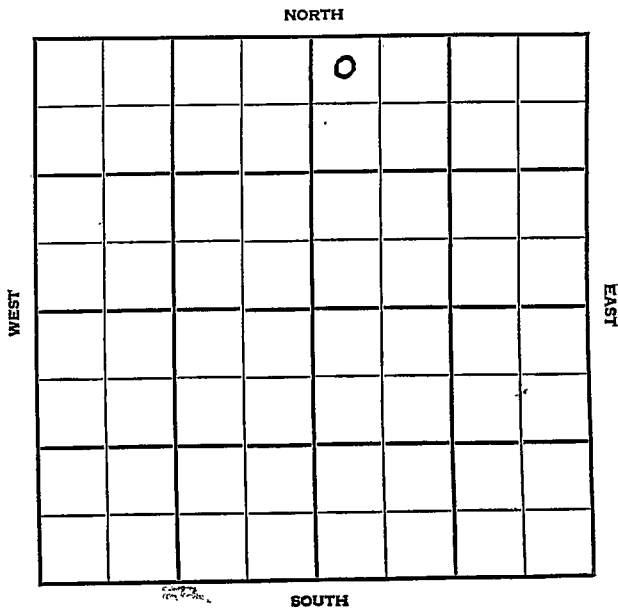

Ellis KANSAS

SEC.	14	TWP.	11	R.	17W
WELL NO.	1 Hall				FARM
COMPANY	DerbyOil				
CONTRACTOR	Peel				

330 \_\_\_\_\_ Ft. from N. Line  
 \_\_\_\_\_ Ft. from S. Line  
 \_\_\_\_\_ Ft. from E. Line  
 330 \_\_\_\_\_ Ft. from W. Line

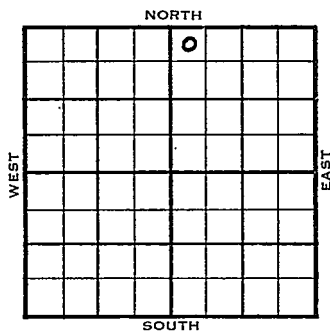

NW NW NE

1954	ELEVATION 1815	REPORT
------	-------------------	--------

7/28 Location  
 8-11 Spdg 7-29-54  
 D&A  
 TD 3379  
 8" @ 1031  
 Anhy 1024 Heeb 2981 Lans. 3023  
 DST 3003-28 open 1/2 hr. Rec. 470' mud  
 0#  
 DST 3076-3104 open 1/2 hr. Rec. 12' mud  
 180#  
 DST 3119-28 open 1/2 hr. Rec. 15' mud  
 210#  
 DST 3151-64 open 1/2 hr. Rec. 8' mud 0#  
 DST 3178-3209 open 1/2 hr. Rec. 10' mud  
 0#  
 DST 3216-54 open 1 1/2 hr. Rec. 30'  
 vsocm 60' ho & gcm 330# Arb. 3375  
 DST 3376-79 open 1/2 hr. Rec. 965' sw  
 940#  
 TD 3379  
 D&A

**ABANDONED**

County Ellis State Kansas

Sec. 14 (Blk. 11) (Sur. Rge.) 17W Map No.

Operator Derby Oil

Well No. 1 Farm Hall

Elev. 1815 Location NW NW NE


330 Ft. From N Line NE

330 Ft. From W Line Quarter

1st. Report

Completion 196 11 1954

Remarks

Peel - Contr.

Spudding Date 7-29-54

Drlg. Data D & A TD 3379

8" @ 1031 Anhy 1024 Heeb. 2981

Lans. 3023 DST 3003-28 open  $\frac{1}{2}$  hr.

Rec. 470' mud 0# DST 3076-3104

open  $\frac{1}{2}$  hr. Rec. 12' mud 180#

DST 3119-28 open  $\frac{1}{2}$  hr. Rec. 15' mud

210# DST 3151-64 open  $\frac{1}{2}$  hr. Rec. 8' mud

0# DST 3178-3209 open  $\frac{1}{2}$  hr. Rec.

10' mud 0# DST 3216-54 open  $1\frac{1}{2}$  hr.

Rec. 30' vsocm 60' ho & gcm 330#

Arb. 3375 DST 3376-79 open  $\frac{1}{2}$  hr.

Rec. 965' sw 940# TD 3379

D & A

