

Section 14 Township 11 Range 17W

Well No. #1 Simpson

Company Lowell Williamson

NORTH

			0				

3

WEST

EAST

SOUTH


SEC.	14	TWP.	11	R.	17W
------	----	------	----	----	-----

WELL NO. #1 Simpson FARM

COMPANY Lowell Williamson

CONTRACTOR Trans Era  
Turkville Pool

330 Ft. from N. Line  
Ft. from S. Line  
330 Ft. from E. Line  
Ft. from W. Line

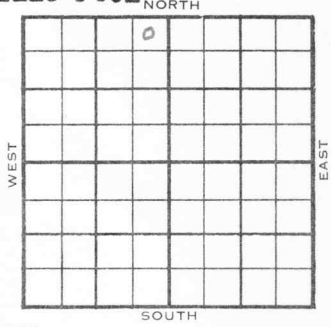

NE NE NW Derby - DHM

	ELEVATION	REPORT
1954	1809	
5/5	Spud 4-29-54 8" @ 200' Drlg 1960'	
5/12	Heeb 2971 Tor 2991 Lans 3012 DST 3045-53, 1 hr, 175' SW DST 3107-16, 1 hr, 1140' free oil 830# Drlg. 3218'	
5/19	B KC 3268 Simp. 3341 Arb. 3363 RTD 3365 5" @ 3363 1/2	
5/26	CO 3365 S/1 BOPH 6 hrs. 250 A FU 1200' oil S/5 BOPH 2 hrs.	
6/2	NR	
6/23	NR	
7/7	"	
8-11	Spdg 4-29-54 Oil well TD 3365 8" @ 200 Heeb 2971 Tor. 2991 Lans. 3012 DST 3045-53 open 1 hr. Rec. 175' sw DST 3107-16 open 1 hr. Rec. 1140' free oil 830# BKC 3268 Simp. 3341 Arb. 3363 TD 3365	

1954

Information brought forward

8-11 5" @ 3363 CO to 3365 S/ 1 boph 6 hr.  
250 A FU 1200' oil S/ 5 boph 2 hr.  
P/ 40 bo 60 bwpd PB 3250 48/3168-74  
SSO 2 gw 1000 A  $2\frac{1}{2}$  boph 6 hr. 2500 A  
4 boph 6 hr. PB 3164 88/3144-55  
SSO & mud 3000 A S/ 6 boph 6 hr. P  
PB 3130 48/ 3107-13 1 boph 2000 A  
S/ 59 bfph 2 hr. 20% wtr. CO to 3250  
P 50 bfpd 50% wtr. Comp. 61 bopd  
55% w

**COMPLETED**

County **Ellis** State **Kansas**

Sec. **14** (Blk.) **11** (Sur.) **17W** Map No. (Twp.) (Rge.)

Operator **Lowell Williamson**

Well No. **1** Farm **Simpson**

Elev. Location **NE NE NW**

		o			

**330** Ft. From **N** Line **NW**

**330** Ft. From **E** Line Quarter

1st. Report **MAY 5 1954**

Completion

Remarks **Derby - DHM**

**Trans-Era - Contr.**

Spudding Date **4-29-54**

Drlg. Data **Turkville Pool**

**8" @ 200 drlg. 1960**



County Ellis State Kansas

Sec. 14 (Blk.) 11 (Sur.) 17W Map No.

Operator Lowell Williamson

Well No. 1 Farm Simpson

Elev. 1809 Location NE NE NW

		<u>0</u>			

330 Ft. From N Line NW

330 Ft. From E Line Quarter

1st. Report

Completion AUG 11 1954

Remarks Turkville Pool

Trans-Era - Contr.

Spudding Date 4-29-54

**COMPLETE**

Drlg. Data Oil well TD 3365

8" @ 200 Heeb. 2971 Tor. 2991

Lans. 3012 DST 3045-53 open 1 hr.

Rec. 175' sw DST 3107-16 open 1 hr.

Rec. 1140' free oil 830# B KC 3268

Simp. 3341 Arb. 3363 TD 3365

5" @ 3363 CO to 3365 S/ 1 boph 6 hr.

250 A FU 1200' oil S/ 5 boph 2 hr.

P/ 40 bo; 60. bwpd PB 3250 48/ 3168-74

SSO 2 gw 1000 A 2 1/2 boph 6 hr. 2500 A

4 boph 6 hr. PB 3164 88/ 3144-55

SSO & mud 3000 A S/ 6 boph 6 hr.

PB 3130 48/ 3107-13 1 boph 2000 A

S/ 59 bfph 2 hr. 20% wtr. CO to 3250

P/ 50 bfpd 50% wtr. Comp. 61 bopd 55%w

72

AUG 17 1954

Secret Cards	<u>Don</u>
Land Small Map	_____
Land Wall Map	<u>3</u>
Tracings	_____
France Map	_____
Pierce Map	_____
Misc.	_____

Orig. Data