

KANSAS

Is here

Form 51-5M-7-39-Palace

Ellis

Section 14 Township 11 Range 17-W

Well No. #7 H. Mai

Company Gulf

NORTH Bemis Pool

9

							0

WEST

EAST

SOUTH

Sec. 14 Twp. 11 R. 17-W

Well No. #7 H. Mai Farm _____

Gulf Company

(Bemis)


990 Ft. from N. Line

_____ Ft. from S. Line

330 Ft. from E. Line

_____ Ft. from W. Line

Elev. 1846

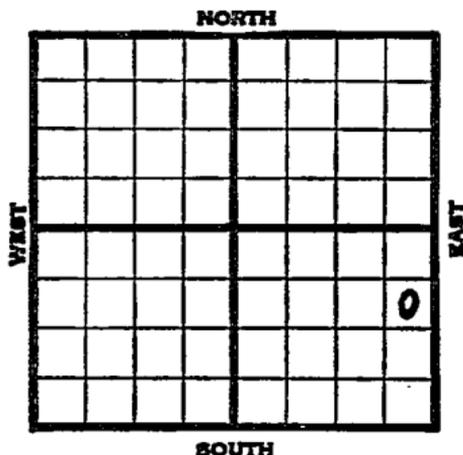

1939	REPORT
10/11	Rotary.
10/19	"
10/26	13" - 129' Drlg. 1170'
11/2	Drlg. 2653'
11/9	Cong. 3309' Simp. 3329'
	Arb. 3359' 5" - 3359'
	T.D. 3360' RUST.
11/16	Bailing mud.
11/22	Arb. 3359'
	5" - 3359'
	T.D. 3361'
	Depthograph 4182' bbls.
	3500 bbls. maximum. bb
	COMPLETED

Map No. 71 Sec. 14 Twp. 11 R. 17W

Well No. 7 H. Mai

Gulf

Company

Contractor

COMPLETED

SECTION PLAT

SE NE SE

990 Ft. from N. Line

_____ Ft. from S. Line

330 Ft. from E. Line

_____ Ft. from W. Line

			o

BEMIS POOL

Location _____

Rig up _____

Drilling and Remarks:

Cor. 3359

5" @ 3359

Depth graph #182

3500 Maximum

RECORD

Cased _____ in., _____ ft.

Sand _____

Gas _____

Oil _____

Total Depth 3361

PRODUCTION

1st 24 hrs. Nat. _____

1st 24 hrs. after shot _____

Gas _____ Cu. Ft.

Dry Hole _____

Abandoned _____

Date

NOV 22 1939

19

S. J. LEWIS

Scout