


Section 14 Township 11 Range 17-W

Well No. 2 Hall "A"

Company Cities Service Oil

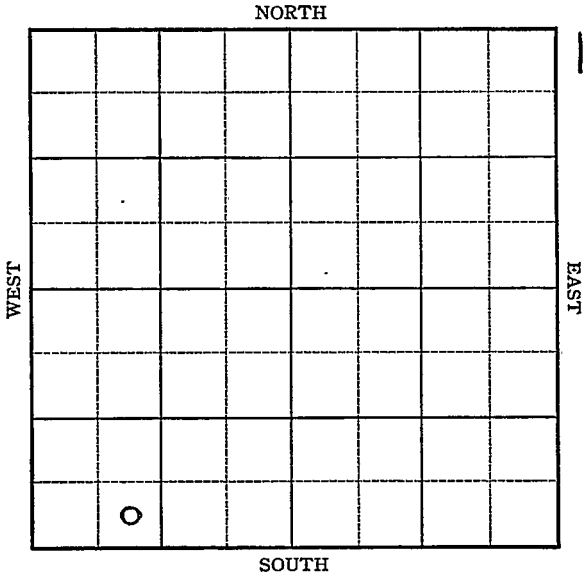

Ellis

KANSAS

Map No. 71 Sec. 14 Twp. 11 R. 17WWell No. 2 Hall "A"Cities Service Oil Company

Contractor

FIRST REPORT

SE SW SW

Ft. from N. Line

330

Ft. from S. Line

Ft. from E. Line

990

Ft. from W. Line

SECTION PLAT

Location _____

Rig up _____

Drilling and Remarks:

BRR

RECORD

Cased _____ in., _____ ft.

Sand _____

Gas _____

Oil _____

Total Depth _____

PRODUCTION

1st 24 hrs. Nat. _____

1st 24 hrs. after shot _____

Gas _____ Cu. Ft.

Dry Hole _____

Abandoned _____

Date

DEC 22 1937 19H. D. Hatfield Scout

Ellis KANSAS

Map No. _____ Sec. 14 Twp. 11 R. 17WWell No. 2 Hall "A"

_____ Cities Service Oil _____ Company

_____ Contractor

COMPLETED

SE SW SW

_____ Ft. from N. Line

330 Ft. from S. Line

_____ Ft. from E. Line

990 Ft. from W. Line**SECTION PLAT**

Location _____

Rig up _____

Drilling and Remarks:

pot 2664
NT

RECORDCased 7 in., 338/ft.~~Sand~~ Arb 3380Gas (corrected)

Oil _____

Total Depth 3388**PRODUCTION**

1st 24 hrs. Nat. _____

1st 24 hrs. after shot _____

Gas _____ Cu. Ft.

Dry Hole _____

Abandoned _____

Date

JAN 26 1938₁₉H. D. Hatfield Scout