

Sec. 14 Twp. 11 R. 17-W

Well No. #3 H. Mai Farm _____

Gulf Company _____

(Bemis)


_____ Ft. from N. Line

330 Ft. from S. Line

_____ Ft. from E. Line

960 Ft. from W. Line

Elev. 1879

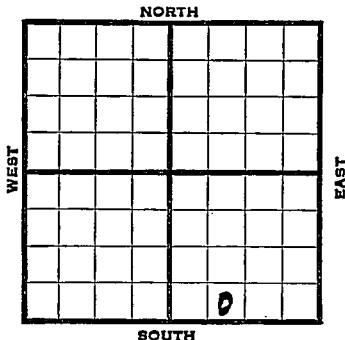

1939	REPORT
5/3	Location
5/12	Rotary rig.
5/19	16" - 53' Drlg. 234'
5/26	Drlg. 2737'
6/1	Circulating 3337'
6/7	Arb. 3374 7" 3374½
	T.D. 3375½
	Depthograph Pot. 8900
	Maximum 3500
	COMPLETED

ELLIS KANSAS

Map No. 71 Sec. 14 Twp. 11 R. 17WWell No. 3 H. Mai

Gulf

Company

Contractor

FIRST REPORT

SE SW SE

SECTION PLAT

			o

_____ Ft. from N. Line

330 Ft. from S. Line

_____ Ft. from E. Line

960 Ft. from W. Line

BEMIS POOL

Location X

Rig up _____

Drilling and Remarks:

RECORD

Cased _____ in., _____ ft.

Sand _____

Gas _____

Oil _____

Total Depth _____

PRODUCTION

1st 24 hrs. Nat. _____

1st 24 hrs. after shot _____

Gas _____ Cu. Ft.

Dry Hole _____

Abandoned _____

Date

MAY 3 1939

19

S. J. LEWIS

Scout

Map No. 71 Sec. 14 Twp. 11 R. 17W

Well No. 3 H. Mai

Gulf

Company

Contractor

COMPLETED

SE SW SE

SECTION PLAT

_____ Ft. from N. Line

330 Ft. from S. Line

_____ Ft. from E. Line

960 Ft. from W. Line

BEMIS POOL

Location _____

RECORD

Rig up _____

Drilling and Remarks:

Cased _____ in., _____ ft.

Sand _____

Gas _____

Oil _____

Total Depth 3,375 1/2

Core 3374

7" @ 3374 1/2

*Depthograph Plot
8900*

*Maximum
3500*

PRODUCTION

1st 24 hrs. Nat. _____

1st 24 hrs. after shot _____

Gas _____ Cu. Ft.

Dry Hole _____

Abandoned _____

Date

JUN 7 1939 19

S. J. LEWIS

Scout