


Section 14 Township 11 Range 17-W

Well No. 4 Hall "A"

Company Cities Service Oil

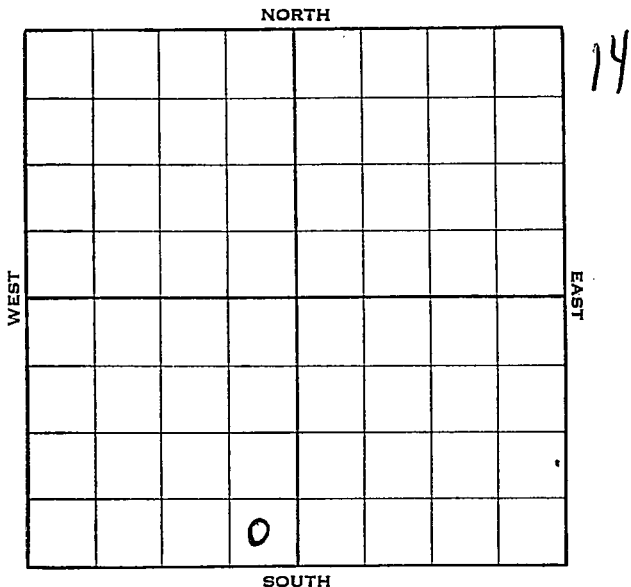

Map No. _____ Sec. 14 Twp. 11 R. 17W

Well No. 4 Hall "A"

Cities Service Oil Company

Contractor _____

FIRST REPORT

SE SW

_____ Ft. from N. Line

330 Ft. from S. Line

330 Ft. from E. Line

_____ Ft. from W. Line

SECTION PLAT

Location _____

Rig up _____

Drilling and Remarks:

RR

RECORD

Cased _____ in., _____ ft.

Sand _____

Gas _____

Oil _____

Total Depth _____

PRODUCTION

1st 24 hrs. Nat. _____

1st 24 hrs. after shot _____

Gas _____ Cu. Ft.

Dry Hole _____

Abandoned _____

Date

OCT 12 1938

19

H. D. Hatfield

Scout

