


Ellis

KANSAS

Section 14 Township 11 Range 17-W

Well No. 1 ~~Hancock Life Ins.~~ Henry Mai

Company Gulf Oil

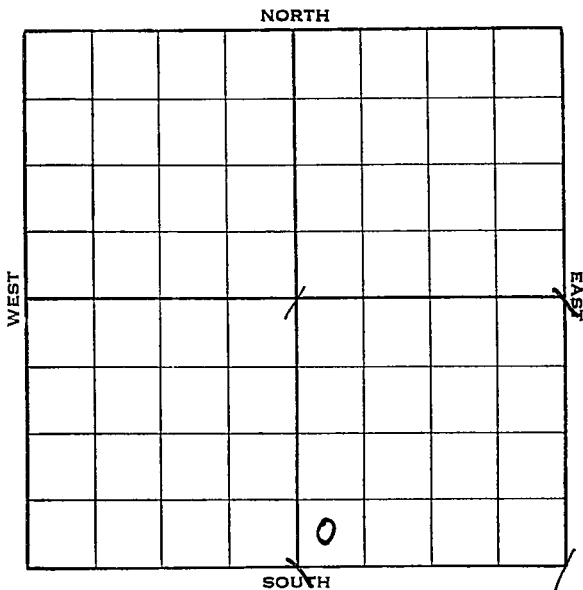

Map No. 71 Sec. 14 Twp. 11 R. 17W

Well No. 1 Hancock Life Ins.

Gulf Oil

Company

Contractor

FIRST REPORT

SW SE


_____ Ft. from N. Line

330 Ft. from S. Line

_____ Ft. from E. Line

330 Ft. from W. Line

SECTION PLAT

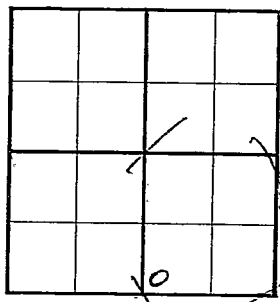

Location _____

Rig up _____

Drilling and Remarks:

RR

RECORD

Cased _____ in., _____ ft.

Sand _____

Gas _____

Oil _____

Total Depth _____

PRODUCTION

1st 24 hrs. Nat. _____

1st 24 hrs. after shot _____

Gas _____ Cu. Ft.

Dry Hole _____

Abandoned _____

Date

OCT 12 1938

19

H. D. Hatfield Scout

Ellis

KANSAS

Map No. 71 Sec. 14 Twp. 11 R. 17W

Well No. 1 Henry Mai

Gulf Oil

Company

Contractor

COMPLETED

SW SE

SECTION PLAT

		0	

_____ Ft. from N. Line

330 Ft. from S. Line

_____ Ft. from E. Line

330 Ft. from W. Line

Location _____

Rig up _____

Drilling and Remarks:

*P.O.T 2800
NAT*

RECORD

Cased 7 in., 3364 ft.

Sand A-6 5363

Gas _____

Oil _____

Total Depth 336.5

PRODUCTION

1st 24 hrs. Nat. _____

1st 24 hrs. after shot _____

Gas _____ Cu. Ft.

Dry Hole _____

Abandoned _____

Date

NOV 22 1938 19

H. D. Hatfield Scout