



Sec. 14 Twp. 11 R. 17-W

Well No. #6 Mai Farm \_\_\_\_\_

Gulf Company

(Bemis)


\_\_\_\_\_ Ft. from N. Line

990 Ft. from S. Line

330 Ft. from E. Line

\_\_\_\_\_ Ft. from W. Line

Elev. 1862

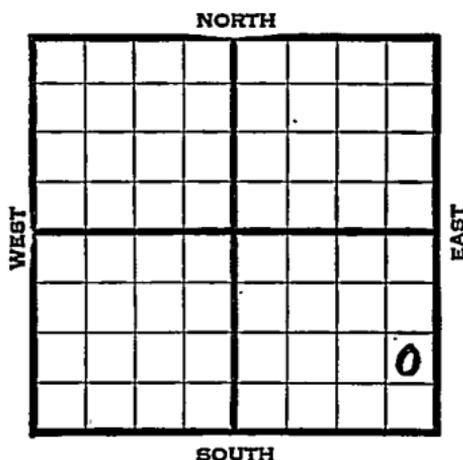

1939	REPORT
7/12	Rotary.
6/20	15" - 80' Anhy 1062'
	9" - 1100' Drlg. 2275'
7/27	Cong. 3330' Simp. 3343'
	Arb. <del>3373 1/2</del> <sup>3370 1/2</sup> T.D. <del>3374</del> <sup>3372</sup>
	Run 6".
8/3	Arb. 3370 1/2 (Corrected)
	5" - 3371' T.D. 3372'
	Swab 246 oil 6 hours.
8/9	Arb. 3370 1/2 (Corrected)
	5" - 3371'
	T.D. 3372'
	Echometer pot. 4280 bbls.
	Maximum 3500 bbls.
	<b>COMPLETED</b>

Ellis

Map No. \_\_\_\_\_ Sec. 14 Twp. 11 R. 17WWell No. 6 MaiGulf

Company

~~FIRST REPORT~~

Contractor

NE SE SE

## SECTION PLAT

\_\_\_\_\_ Ft. from N. Line

990 Ft. from S. Line330 Ft. from E. Line

\_\_\_\_\_ Ft. from W. Line

BEMIS POOL

			o

Location \_\_\_\_\_

## RECORD

Rig up \_\_\_\_\_

Drilling and Remarks:

Rotary

Cased \_\_\_\_\_ in., \_\_\_\_\_ ft.

Sand \_\_\_\_\_

Gas \_\_\_\_\_

Oil \_\_\_\_\_

Total Depth \_\_\_\_\_

## PRODUCTION

1st 24 hrs. Nat. \_\_\_\_\_

1st 24 hrs. after shot \_\_\_\_\_

Gas \_\_\_\_\_ Cu. Ft.

Dry Hole \_\_\_\_\_

Abandoned \_\_\_\_\_

Date

12 12 1939

19

Scout

