


Section 14 Township 11 Range 17-W

Well No. #5 Mai

Company Gulf

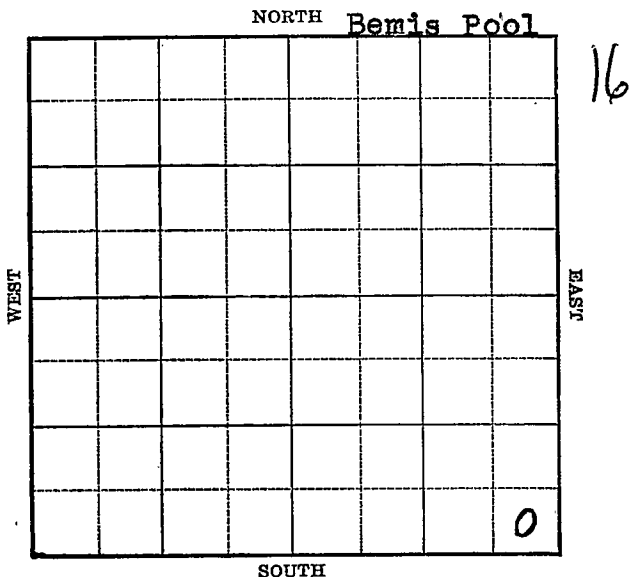

Sec. 14 Twp. 11 R. 17-W

Well No. #5 Mai Farm \_\_\_\_\_

Gulf Company


(Bemis)

\_\_\_\_\_ Ft. from N. Line

330 Ft. from S. Line

330 Ft. from E. Line

\_\_\_\_\_ Ft. from W. Line

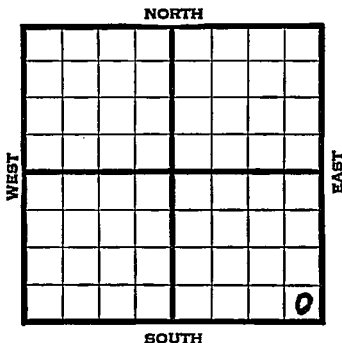

1939	REPORT
6/27	Cen lar.
6/29	15" - 75' Anhy 1080'
	8" - 1096' Drig. 1160'
7/6	Lans. 3115' Cong. 3353'
	Drig. 3365'
7/12	Arb. 3392'
	7" - 3392½'
	T.D. 3394'
	Depthograph potential 42,500 bbls
	Maximum 3500 bbls.
	COMPLETED

Map No. \_\_\_\_\_ Sec. 14 Twp. 11 R. 17W

Well No. 5 Mai

Gulf

Company

Contractor

FIRST REPORT

SE/C

SECTION PLAT

\_\_\_\_\_ Ft. from N. Line

330 Ft. from S. Line

330 Ft. from E. Line

\_\_\_\_\_ Ft. from W. Line

			2

BEMIS POOL

Location \_\_\_\_\_

Rig up \_\_\_\_\_

Drilling and Remarks:

**Cellar**

RECORD

Cased \_\_\_\_\_ in., \_\_\_\_\_ ft.

Sand \_\_\_\_\_

Gas \_\_\_\_\_

Oil \_\_\_\_\_

Total Depth \_\_\_\_\_

PRODUCTION

1st 24 hrs. Nat. \_\_\_\_\_

1st 24 hrs. after shot \_\_\_\_\_

Gas \_\_\_\_\_ Cu. Ft.

Dry Hole \_\_\_\_\_

Abandoned \_\_\_\_\_

Date

**JUN 21 1939**

19

**S. J. LEWIS**

Scout

Map No. \_\_\_\_\_ Sec. 14 Twp. 11 R. 17W

Well No. 5 Mai

Gulf

Company \_\_\_\_\_

Contractor \_\_\_\_\_

**COMPLETED**

**SE/C**

\_\_\_\_\_ Ft. from N. Line

330 Ft. from S. Line

330 Ft. from E. Line

\_\_\_\_\_ Ft. from W. Line

**SECTION PLAT**


**BEMIS POOL**

Location \_\_\_\_\_

Rig up \_\_\_\_\_

Drilling and Remarks:

*Cor. 8. 3392.*

*7" @ 3392 1/2.*

*Depthograph P & X  
4250*

*Maximum*

*3500*

**RECORD**

Cased \_\_\_\_\_ in., \_\_\_\_\_ ft.

Sand \_\_\_\_\_

Gas \_\_\_\_\_

Oil \_\_\_\_\_

Total Depth 3394

**PRODUCTION**

1st 24 hrs. Nat. \_\_\_\_\_

1st 24 hrs. after shot \_\_\_\_\_

Gas \_\_\_\_\_ Cu. Ft.

Dry Hole \_\_\_\_\_

Abandoned \_\_\_\_\_

Date

JUL 12 1929

19

**S. J. LEWIS**

Scout