


Section 15 Township 11 Range 16WWell No. #1 Anna BaumCompany Gulf & Westgate-Greenland

NORTH

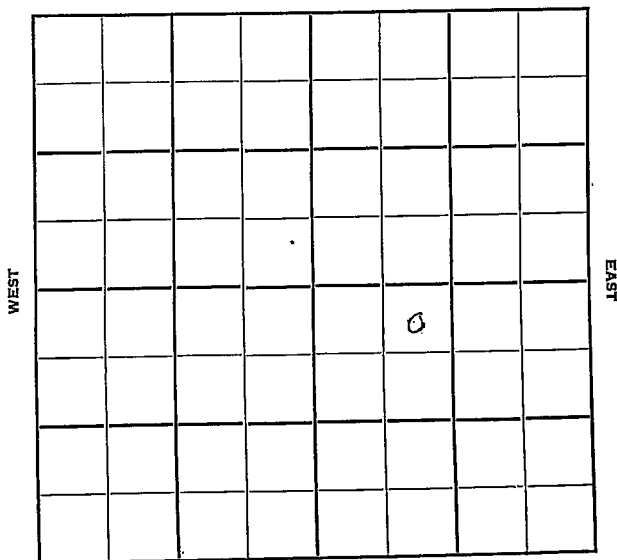

SOUTH

Ellis

KANSAS

Sec. 15 Twp. 11 R. 16W

Well No. #1 Anna Baum Farm

Gulf & Westgate-Greenland Company

Contractor

Wildcat


330' Ft. from N. Line

Ft. from S. Line

Ft. from E. Line

990' Ft. from W. Line

NE NW SE

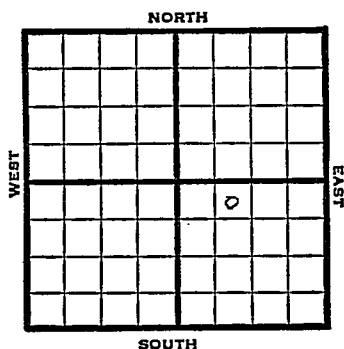

1950

Elev 1847'

REPORT

1/25 Cellar & Pits

2/15

TD 3521'

8" @ 1042'

Lans 3079'

Cong 3486'

Arb. 3514'

DST 3514-21

Rec wtr.

D&A

Aband.

ABANDONED

Kansas

Wildcat

Map No. _____ Sec. 15 Twp. 11 R. 16W

Well No. 1 Anna Baum

Gulf & Westgate-Greenland Company

Contractor

NE NW SE


330 Ft. from N. Line

Ft. from S. Line

Ft. from E. Line

990 Ft. from W. Line

SECTION PLAT

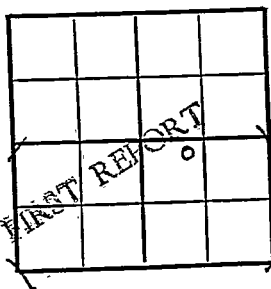

Ellis Courty

Location _____

Rig up _____

Drilling and Remarks:

Cellar & pits

RECORD

Cased _____ in., _____ ft.

Sand _____

Gas _____

Oil _____

Total Depth _____

PRODUCTION

1st 24 hrs. Nat. _____

1st 24 hrs. after shot _____

Gas _____ Cu. Ft.

Dry Hole _____

Abandoned _____

Date

J. E. TYRA

JAN 25 1950 19

Scout

Kansas

Map No. _____ Sec. 15 Twp. 11 R. 16W

Well No. 1 Anna Baum

Gulf et al. _____ Company

Contractor

NE NW SE


E1. 1847
SECTION PLAT

330 Ft. from N. Line

Ft. from S. Line

Ft. from E. Line

990 Ft. from W. Line

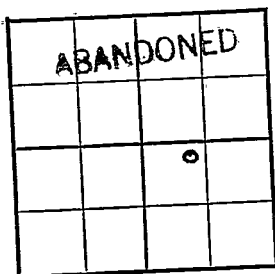

Ellis County

Location _____

Rig up _____

Drilling and Remarks:

8" @ 1042

Lana 3079

Cong 3486

Ave 3514

D.S.T. 3514-21

no water

RECORD

Cased _____ in., _____ ft.

Sand _____

Gas _____

Oil _____

Total Depth 3521

PRODUCTION

1st 24 hrs. Nat. _____

1st 24 hrs. after shot _____

Gas _____ Cu. Ft.

Dry Hole _____

Abandoned _____

Date

FEB 15 1950 19

J. E. TYRA

Scout