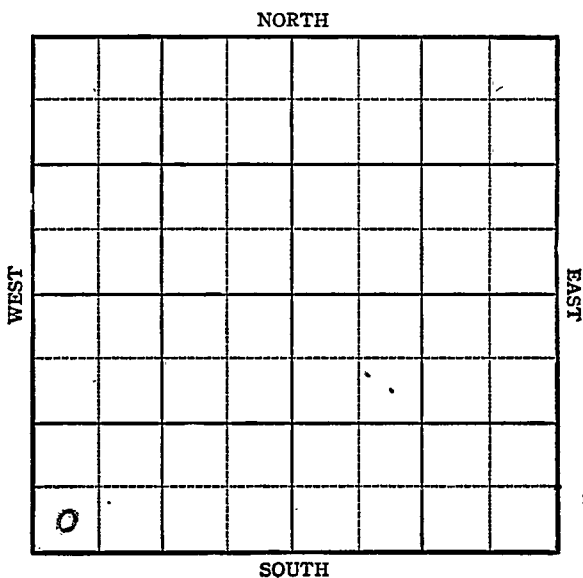


KANSAS

Ottawa

Section 15 Township 11 Range 1WWell No. #1 KatherCompany Phil ips

Ottawa

Sec. 15 Twp. 11 R. 1W

Well No. #1 Kather Farm

Phillips Company

NORTH

 Ft. from N. Line

330 Ft. from S. Line

 Ft. from E. Line

330 Ft. from W. Line

Elev. 1380

WEST

EAST

SOUTH

SW/c

1944

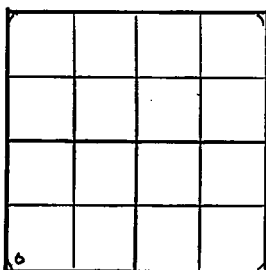
R E P O R T

7/26	Location
8/2	"
8/9	Drlg. 1895
8/16	Drlg. 2824
8/23	Drlg. 3604
8/30	Lans 2055
	Miss 2688
	Hunton 3083
	Viola 3387
	Simp 3485
	Arb 3580
	TD 3630

ABANDONED

Pool Name Wildcat

KANSAS
 Map No. 51 Sec. 15 Twp. 11 R. 1W

Well No. 1 KatherPhillips Company**FIRST REPORT**SW/C Contractor**SECTION PLAT** Ft. from N. Line330 Ft. from S. Line Ft. from E. Line330 Ft. from W. LineOttawa CountyLocation XRig up

Drilling and Remarks:

RECORDCased in., ft.Sand Gas Oil Total Depth **PRODUCTION**1st 24 hrs. Nat. 1st 24 hrs. after shot Gas Cu. Ft.Dry Hole Abandoned

Date

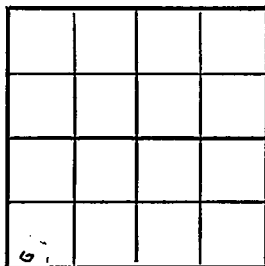
JUL 26 194419S. J. LEWISScout

Pool Name WildcatMap No. 51 Sec. 15 Twp. 11 R. 1WWell No. 1 KatherPhillips Company**ABANDONED**

Contractor

SW/C

SECTION PLAT

 Ft. from N. Line330 Ft. from S. Line Ft. from E. Line330 Ft. from W. LineOttawa CountyLocation Rig up

Drilling and Remarks:

*Lane 2055**Miss 2688**Hunter 3083**Vista 3287**Simp 3483**Art 3580*

RECORD

Cased in., ft.Sand Gas Oil Total Depth 3630

PRODUCTION

1st 24 hrs. Nat. 1st 24 hrs. after shot Gas Cu. Ft.Dry Hole Abandoned

Date

AUG 30 1944

19

S. J. LEWIS

Scout