KANSAS
FORM 51 IOM 12-46 PETROL


Ellis

Section 15 Township 11 Range 18-W

Well No. 1 Opdycke "B"

Company H. H. Blair

Burnett Pool

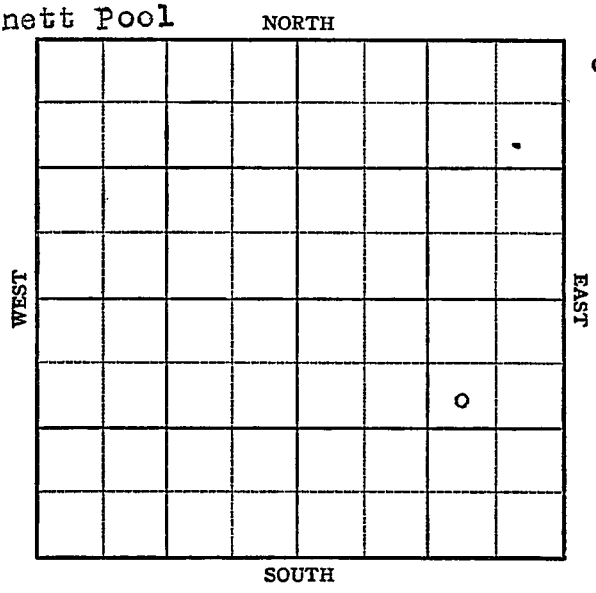

FORM 252-A
5M 9-47 PETROL

KANSAS Ellis

Sec. 15 Twp. 11 R. 18W

Well No. #1 Opdycke "B" Farm

H H. Blair Company


990 Ft. from N. Line

Ft. from S. Line

990 Ft. from E. Line

Ft. from W. Line

SW NE SE

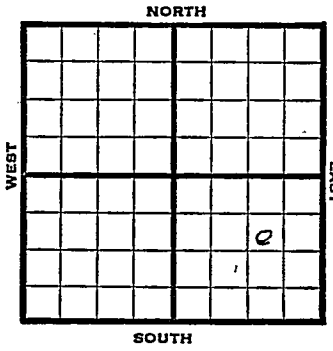

1947	REPORT
9/17	8" @ 167' Anhy. 1198' Drlg. 2951'
9/24	Lansing 3153'
10/1	BKC 3370' Conglomerate 3400' Simpson 3461' Arbuckle 3479' TD 3520' SO & W 5" @ 3518' RUST
10/8	24 shots 3482-87-2250' oil & 150' W in 16 hrs.
10/15	"
10/22	"
10/29	"
11/5	"
11/12	"

OVER

1947

11/25 Arbuckle 3479
5" @ 3518
Perf.
Echo Pot 3,000
TD 3520
Gravity 36.7

COMPLETED

Form 26 200 Bks. 10-46 Petrol

Kansas

Burnett Pool

Map No. 7/ Sec. 15 Twp. 11 R. 18W

Well No. 1 Opdycke "B"

H. H. Blair Company

FIRST REPORT Contractor

SW NE SE


990 Ft. from N. Line

Ft. from S. Line

990 Ft. from E. Line

Ft. from W. Line

SECTION PLAT

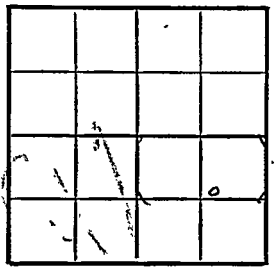

Ellis County

Location

Rig up

Drilling and Remarks:

8" @ 167

anhy 1198

drlg 2951

RECORD

Cased in., ft.

Sand

Gas

Oil

Total Depth

PRODUCTION

1st 24 hrs. Nat.

1st 24 hrs. after shot


Gas Cu. Ft.

Dry Hole

Abandoned

Date

SEP 17 1947 19 S. I. LEWIS Scout

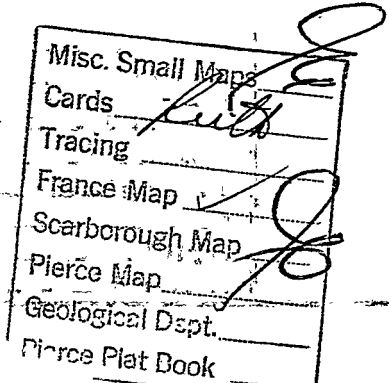
Misc. Small Maps
Cards
Tracing
France Map
Scarborough Map
Pierce Map
Geological Dept.
Pierce Plat Book

Form 26 200 Bks. 10-46 Petrol

Burnett Pool

Kansas

Map No. 71 Sec. 15 Twp. 11 R. 18W

Well No. 1 Opdycke "B"


H. H. Blair Company

COMPLETE Contractor

SW NE NE

E 1/1920

SECTION PLAT

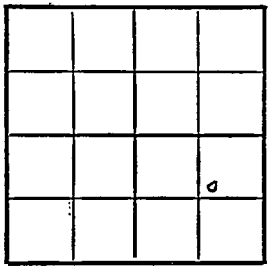

990 Ft. from N. Line

Ft. from S. Line

990 Ft. from E. Line

Ft. from W. Line

Ell is County

Location

Rig up

Drilling and Remarks:

Cr Y3479

5" "C2357?

Dry

Echo Pt 3000

8637

RECORD

Cased in., ft.

Sand

Gas

Oil

Total Depth 3520

PRODUCTION

1st 24 hrs. Nat.

1st 24 hrs. after shot

Gas Cu. Ft.


Dry Hole

Abandoned

Date

NOV 25 1947 19

S. J. LEWIS Scout

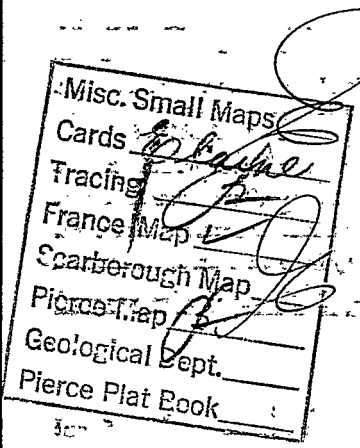
Misc. Small Maps
Cards
Tracing
France Map
Scarborough Map
Pierce Map
Geological Dept.
Pierce Plat Book