

KANSAS

Ellis

FORM 51 IOM 12-46 PETROL

Section 15 Township 11 Range 18-WWell No. 1 HendersonCompany H. H. Blair

Burnett Pool

NORTH

WEST

EAST

	.						
	o						

SOUTH

13

KANSAS

Ellis

Sec. 15 Twp. 11- R. 18W

Well No. #1 Henderson Farm

H. H. Blair Company


 Ft. from N. Line

330 Ft. from S. Line

990 Ft. from E. Line

990 Ft. from W. Line

~~SW SE SW~~ SE SWSW

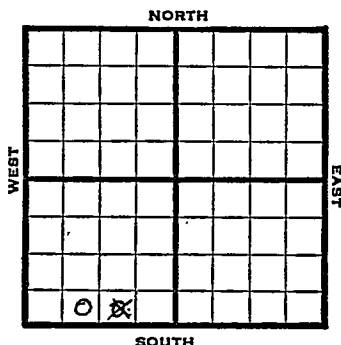

1947	Elev. 1901 REPORT
9/17	RUR
9/24	8" @ 133' Anhydrite 1210' SD 2085' eng. repairs.
10/1	Lansing 3136' Drlg. 3280' SO
10/8	Arbuckle 3452' TD 3454' 5" @ 3453' RUST
10/15	TD 3455' 2650' oil in 18 hrs.
10/22	"
10/29	"
11/5	"
11/12	"
11/25	Arbuckle 3452 5" @ 3453 1000 Acid Echo Pot 3000 TD 3455 Gravity 36
	COMPLETE

Map No. 71 Sec. 15 Twp. 11 R. 18W

Well No. 1 Henderson

H. H. Blair Company

CORRECTION

Contractor

SE SW SW


SECTION PLAT

 Ft. from N. Line

330 Ft. from S. Line

 Ft. from E. Line

990 Ft. from W. Line

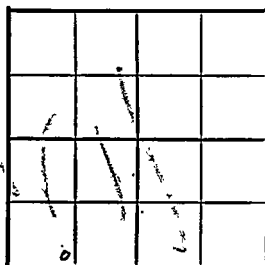

Ellis County

Location

Rig up

Drilling and Remarks:

Reported

SW SE SW

RECORD

Cased in., ft.

Sand

Gas

Oil

Total Depth

PRODUCTION

1st 24 hrs. Nat.

1st 24 hrs. after shot

Gas Cu. Ft.

Dry Hole

Abandoned

Date

SEP 17 1947

19

S. J. LEWIS

Scout

Map No. 71 Sec. 15 Twp. 11 R. 18W

Well No. 1 Henderson

H. H. Blair Company

FIRST REPORT Contractor

SW SE SW


SECTION PLAT

 Ft. from N. Line

330 Ft. from S. Line

990 Ft. from E. Line

 Ft. from W. Line

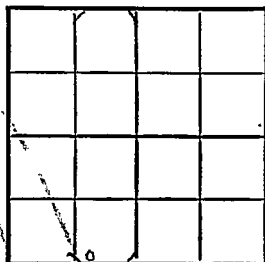

Ellis County

Location

Rig up

Drilling and Remarks:

R U R

RECORD

Cased in., ft.

Sand

Gas

Oil

Total Depth

PRODUCTION

1st 24 hrs. Nat.

1st 24 hrs. after shot

Gas Cu. Ft.

Dry Hole

Abandoned

Date

SEP 17 1947 19

S. J. LEWIS Scout

Kansas


Map No. 91 Sec. 15 Twp. 11 R. 18WWell No. 1 HendersonH. H. Blair

Company

COMPLETE

Contractor

SE SW SW

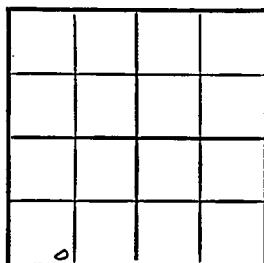E11901
SECTION PLAT Ft. from N. Line330 Ft. from S. Line Ft. from E. Line990 Ft. from W. Line

Ellis County

Location Rig up

Drilling and Remarks:

*CR 83452**5' C 83453**1000 acid**Ech 83453 3000**362 ft.***RECORD**Cased in., ft.Sand Gas Oil Total Depth 3455**PRODUCTION**1st 24 hrs. Nat. 1st 24 hrs. after shot Gas Cu. Ft.Dry Hole Abandoned

Date

NOV 25 1947 19

S. J. LEWIS

Scout