

Section 15 Township 11 Range 18W

Well No. 2 Henderson

Company Berry & Shay

Burnett
NORTH

| | | | | | | | |
|--|--|--|--|--|--|--|--|
| | | | | | | | |
| | | | | | | | |
14

WEST

EAST

SOUTH

0

KANSAS

Ellis

Sec. 15 Twp. 11 R. 18W

Well No. #2 Henderson Farm

Berry & Shay Company

Burnett Pool


_____ Ft. from N. Line

990' Ft. from S. Line

330' Ft. from E. Line

_____ Ft. from W. Line

NE SE SW

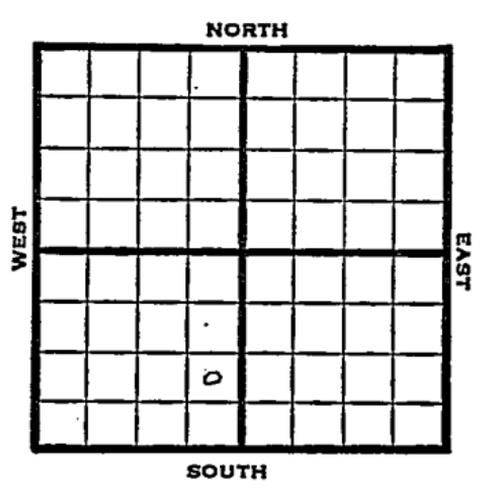

1949

Elev 1955' REPORT

- 1/19 ^U Surface Hole
- 1/26 8" @ 163
Drlg 2270'
- 2/2 BKC 3426'
Arbuckle 3511'
Drlg. 3525'
- 2/9 TD 3543
5" @ 3542'
- 2/16 "
- 2/23 "
- 3/2 "
- 3/8 "
- 3/16 "
- 3/23 "
- 3/30 "
- 4/6 TD 3543'
Arb. 3511'
5" @ 3542'
Perf 500 acid
Pump 530 Oil / 8% W Pot
36° Gr.
Gomp

COMPLETED

Kansas

Map No. _____ Sec. 15 Twp. 11 R. 18W

Well No. 2 Henderson

Berry & Shay Company

FIRST REPORT Contractor

NE SE SW

SECTION PLAT

_____ Ft. from N. Line

990 _____ Ft. from S. Line

330 _____ Ft. from E. Line

_____ Ft. from W. Line

| | | | |
|--|--|--|--|
| | | | |
| | | | |
| | | | |
| | | | |

Ellis County

RECORD

Location _____

Cased _____ in., _____ ft.

Rig up _____

Sand _____

Drilling and Remarks:

Gas _____

Oil _____

surface hole

Total Depth _____

PRODUCTION

1st 24 hrs. Nat. _____

1st 24 hrs. after shot _____

Gas _____ Cu. Ft.

Dry Hole _____

Abandoned _____

Date

JAN 1 9 1949 19

S. J. LEWIS

Scout

