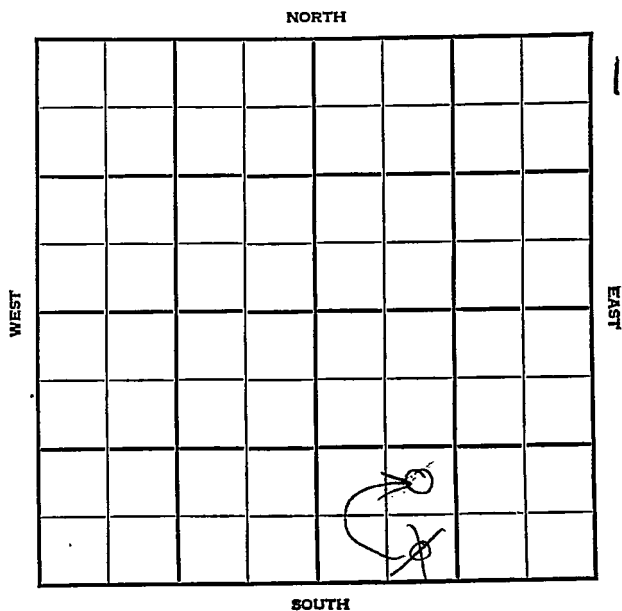


Section 15 Township 11 Range 18-WWell No. #1 OpdyckeCompany H H Blair

KANSAS

Ellis

Sec. 15 Twp. 11 R. 18WWell No. #4 Opdycke FarmH. H. Blair Company


Burnett Pool

Ft. from N. Line

990~~330~~

Ft. from S. Line

Ft. from E. Line

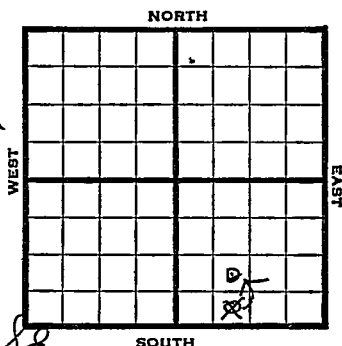990 Ft. from W. Line~~SE SW SE~~*NE SW SE*

1948	Elev. 1923'	REPORT
7/21	Location	
7/28	RUR	
8/4	8" @ 200'	
	Drlg. 3000'	
8/11	Topeka 2889'	
	Lansing 3160'	
	Conglomerate 3410'	
	Drlg 3443'	
8/18	TD 3485'	
	5" @ 3485'	
8/25	Arbuckle 3480'	
	5" @ 3480'	
	TD 3482'	
9/1	"	
9/8	"	
9/14	12 shots 3190-95	1050 Oil
9/21	"	
9/29	Arbuckle 3480'	
	5" @ 3480'	
	Lans 3160'	
	Perf Lans	
	4000 acid	
	Pump 92 oil Pot	
	Gr. 36°	
	TD 3482'	
	COMPLETED	

Map No. _____ Sec. 15 Twp. 11 R. 18W

Well No. 4 Opdycke

H. H. Blair Company

FIRST REPORT Contractor

SE SW SE

SECTION PLAT

_____ Ft. from N. Line

330 Ft. from S. Line

_____ Ft. from E. Line

990 Ft. from W. Line

Ellis County

Location X

Rig up

Drilling and Remarks:

RECORD

Cased _____ in., _____ ft.

Sand _____

Gas _____

Oil _____

Total Depth _____

PRODUCTION

1st 24 hrs. Nat. _____

1st 24 hrs. after shot _____

Gas _____ Cu. Ft.

Dry Hole _____

Abandoned _____

Date

JUL 21 1948 19 S. J. LEWIS Scout

Ellis County Kansas State

Map No. 71 Sec. 15 Twp. 11 R. 18W


Well No. 4 Opdycke

H. H. Blair Company

CORRECTION Contractor

NE SW SE

SECTION PLAT

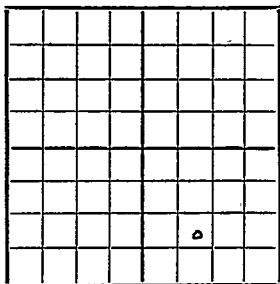

 Ft. from N. Line

990 Ft. from S. Line

 Ft. from E. Line

990 Ft. from W. Line

Burnett Pool
Remarks:

Reported SE SW SE

Date
AUG 4 1948

Scout S. J. LEWIS

Map No. 71 Sec. 15 Twp. 11 R. 18W

Well No. 4 Opdycke

H. H. Blair Company

COMPLETE

Contractor

NE SW SE


E 11923
SECTION PLAT

 Ft. from N. Line

990 Ft. from S. Line

 Ft. from E. Line

990 Ft. from W. Line

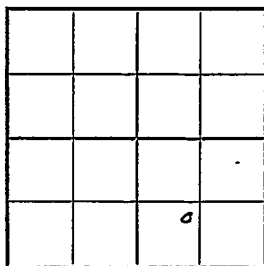

Ellis County

Location

Rig up

Drilling and Remarks:






Pump 92 oil 24
36 2/3

RECORD

Cased in., ft.

Sand

Gas

Oil ✓

Total Depth 3482

PRODUCTION

1st 24 hrs. Nat.

1st 24 hrs. after shot

Gas Cu. Ft.

Dry Hole

Abandoned

Date

SEP 29 1948

19

S. J. LEWIS

Scout