

KANSAS

FORM 51 5M 6-46 PETROL

Ellis

Section 15 Township 11 Range 18W

Well No. 1 Opdyoke

Company H.H. Blair

NORTH

WEST

EAST

SOUTH

16


0

Sec. 15 Twp. 11 R. 18WWell No. #1 Opdyoke FarmH. H. Blair Company

Burnett

 Ft. from N. Line330 Ft. from S. Line330 Ft. from E. Line Ft. from W. Line

SE/c

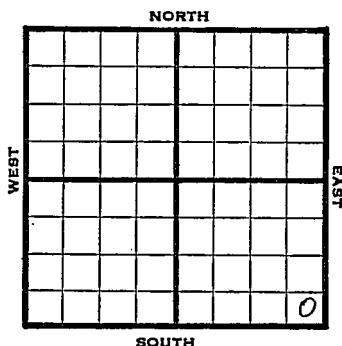

1946	REPORT		
	<i>1936</i>		
7/3	8" @ 133 Anhy 1220 Drlg. 2921'		
7/9	Topeka 2905	Lans 3170	
	So Cong 3430	Simp 3466	
	Arb 3493-97		
	TD 3497		
	VSS0, 5" @ 3493	RUST	
7/16	"	"	
7/23	"	"	
7/30	"	"	
8/6	"	"	
8/13	TD3522 PB 3410-23 shots 3207-11 2800' oil, 13 hrs		
8/20	"	"	"
8/27	"	"	"
9/5	"	"	"
9/10	"	"	"
9/18	"	"	"
9/24	"	"	"
10/1	"	"	"
10/8	"	"	"
10/15	"	"	"
10/22	"	"	"
10/29	"	"	"
OVER			

1946

11/6 Lans 3170'
 Arb 3493'
 TD 3522'
 5" @ 3493'
 Perf Lans
 Pump 302 POT
 Grav. 27

COMPLETED

KANSAS

Kansas Pool Name BurnettMap No. 7/ Sec. 15 Twp. 11 R. 18WWell No. 1 OpdyokeH. H. Blair


Company

FIRST REPORT

Contractor

SE/C

SECTION PLAT

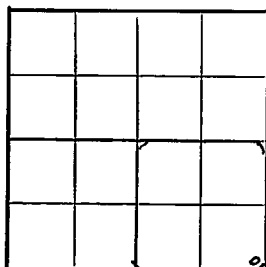 Ft. from N. Line330 Ft. from S. Line330 Ft. from E. Line Ft. from W. LineEllis CountyLocation Rig up

Drilling and Remarks:

8" @ 133'

Anhy 1220'

2921'

RECORD

Cased in., ft.Sand Gas Oil Total Depth

PRODUCTION

1st 24 hrs. Nat. 1st 24 hrs. after shot Gas Cu. Ft.Dry Hole Abandoned

Date

JUL 3 1946 19S. J. LEWIS Scout

Misc. Small Maps

Cards

Tracing

France Map

Scarborough Map

Pierce Map

Geological Dept.

Pierce

KANSAS

Burnett Pool

Map No. 71 Sec. 15 Twp. 11 R. 18W

Well No. 1 Opdycke


H. H. Blair Company

COMPLETED

Contractor

SE/C

21, 1936
SECTION PLAT

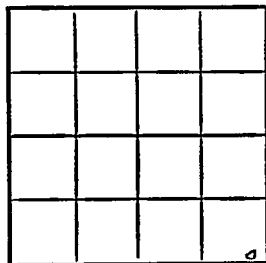

 Ft. from N. Line

330 Ft. from S. Line

330 Ft. from E. Line

 Ft. from W. Line

Ellis County

Location

Rig up

Drilling and Remarks:

Line 3170
Co Y 3493
5" Co 3493
Perryman.
Pump 302 Pst

27 2/3

RECORD

Cased in, ft.

Sand

Gas

Oil

Total Depth 2522

PRODUCTION

1st 24 hrs. Nat.

1st 24 hrs. after shot

Gas Cu. Ft.

Dry Hole


Abandoned

Date

NOV 6 1946 19

S. J. LEWIS

Scout

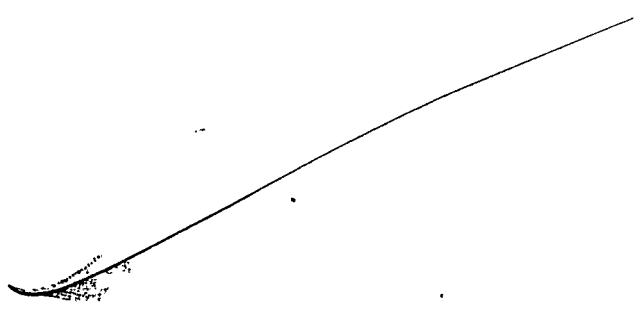

Misc. Small Maps	<i>[initials]</i>
Cards	<i>Sarah</i>
Tracing	<i>[initials]</i>
France Map	<i>[initials]</i>
Scarborough Map	<i>[initials]</i>
Pierce Map	<i>[initials]</i>
Geological Dept.	
Pierce Plat Book	