


Ellis

KANSAS

Section 15 Township 11 Range 18W

Well No. #8 Opdyke "A"

Company H. H. Blair

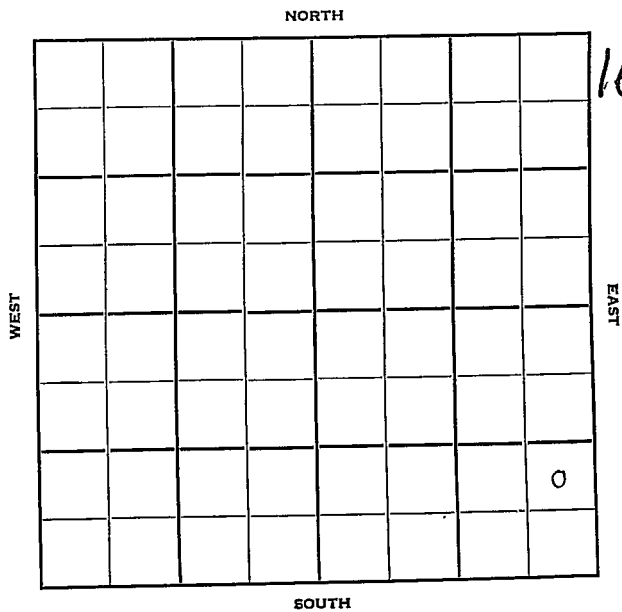

Sec. 15 Twp. 11 R. 18W ✓

Well No. #8 Opdyke "A" Farm

H. H. Blair Company

H. H. Blair Contractor

Burnett Pool


\_\_\_\_\_ Ft. from N. Line

990' Ft. from S. Line

330' Ft. from E. Line

\_\_\_\_\_ Ft. from W. Line

NE SE SE

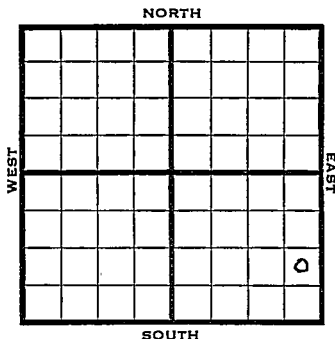

1950

Elev 1917

REPORT

3/29

Spud- 3-23-50  
8-5/8" @ 130'  
Anhy 1209'  
Drlg. 1357'

5/17

TD 3483  
8 5/8" @ 130  
Topeka 2881  
Lans 3150  
Cong 3412  
Abr 3478  
5 1/2" @ 3479  
plug back to 3062  
perf 21/3047-50  
P 51 BOPD & 33% wtr  
Completed

**COMPLETED**

Map No. \_\_\_\_\_ Sec. 15 Twp. 11 R. 18W

Well No. 8 Opdyke "A"

H. H. Blair \_\_\_\_\_ Company

H. H. Blair \_\_\_\_\_ Contractor

NE SE SE


## SECTION PLAT

\_\_\_\_\_ Ft. from N. Line

990 Ft. from S. Line

330 Ft. from E. Line

\_\_\_\_\_ Ft. from W. Line

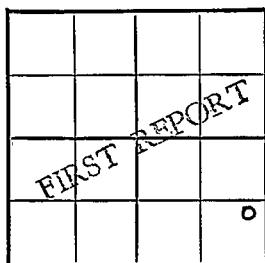

Ellis County

Location \_\_\_\_\_

Rig up \_\_\_\_\_

Drilling and Remarks:

Spud 3-23-50

8 5/8" @ 130

Anhy 1209

drlg. 1357

## RECORD

Cased \_\_\_\_\_ in., \_\_\_\_\_ ft.

Sand \_\_\_\_\_

Gas \_\_\_\_\_

Oil \_\_\_\_\_

Total Depth \_\_\_\_\_

## PRODUCTION

1st 24 hrs. Nat. \_\_\_\_\_

1st 24 hrs. after shot \_\_\_\_\_

Gas \_\_\_\_\_ Cu. Ft.

Dry Hole \_\_\_\_\_

Abandoned \_\_\_\_\_

Date

MAR 29 1950

19

J. E. TYRA

Scout

*Kansas*

 Map No. \_\_\_\_\_ Sec. 15 Twp. 11 R. 18W
Well No. 8 Ondyke "A"\_\_\_\_\_ H. H. Blair \_\_\_\_\_ Company

\_\_\_\_\_ Contractor

NE SE SE

E1. 1917  
SECTION PLAT

\_\_\_\_\_ Ft. from N. Line

990 Ft. from S. Line330 Ft. from E. Line

\_\_\_\_\_ Ft. from W. Line

COMPLETE			
			○

Ellis

Location \_\_\_\_\_

Rig up \_\_\_\_\_

Drilling and Remarks:

*8 5/8" @ 130*  
*Topok 2881*  
*Lanz 3150*  
*cong 3412*  
*and 3478*  
*5 1/2" @ 3479*

## RECORD

Cased \_\_\_\_\_ in., \_\_\_\_\_ ft.

Sand \_\_\_\_\_

Gas \_\_\_\_\_

Oil \_\_\_\_\_

Total Depth 3483

## PRODUCTION

1st 24 hrs. Nat. \_\_\_\_\_

1st 24 hrs. after shot \_\_\_\_\_

Gas \_\_\_\_\_ Cu. Ft.

Dry Hole \_\_\_\_\_

Abandoned \_\_\_\_\_

*Plug Back to 3062 perf 21/3047-50*  
 Date \_\_\_\_\_

MAY 17 1950

19

J. E. TYRA Scout