


Section 15 Township 11 Range 19 W

Well No. # 4 Fred

Company Okmar

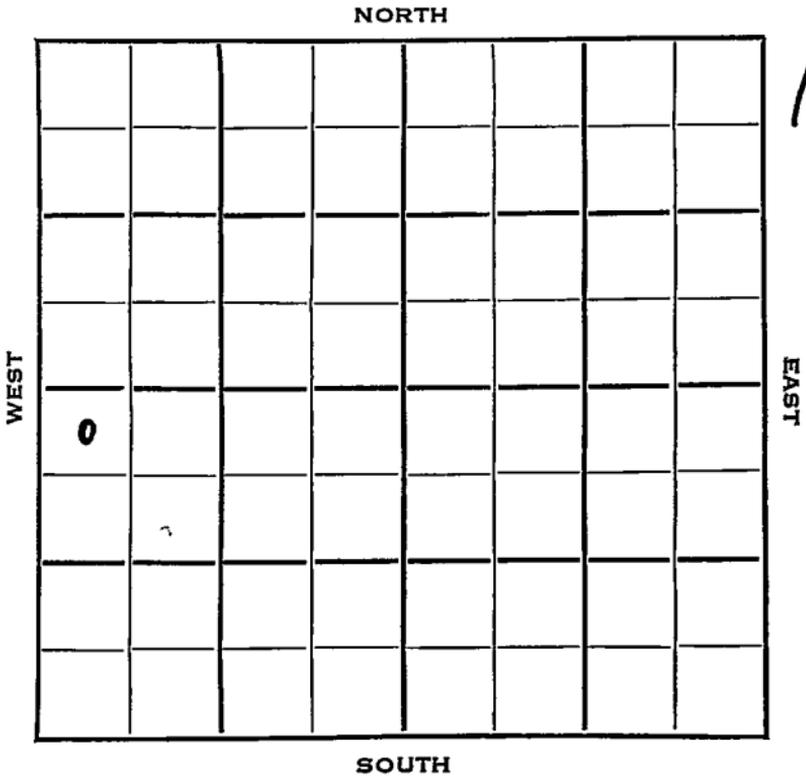

Ellis
11

KANSAS
R. 19W



Sec. 15 Twp. _____ R. _____

Well No. #4 Fred Farm _____

Okmar Company _____

Nye Contractor _____


330 Ft. from N. Line

_____ Ft. from S. Line

_____ Ft. from E. Line

330 Ft. from W. Line

NW NW SW

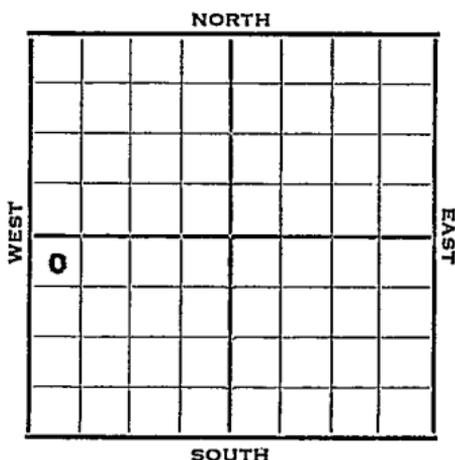

1953 Elev. 1957' REPORT

7/14 Location
 7/22 Anhy 1263 8" @ 1273
 Drlg. 2460'
 7/29 Top 2920, Heeb 3139, Lans 3179, Arb.
 3491,
 RTD 3494
 5" @ 3492'
 85 NR
 8/12 DD 3495 TD S/20 BOPH 4 hrs.
 8/19 NR
 9/2 Spud 7-16-53
 Oil Well
 TD 3495
 Anhy 1263
 8" @ 1273
 Top 2920, Heeb 3139, Lans 3179, Arb.
 3491
 TD 3494
 5" @ 3492
 DD 3495
 5 boph nat. 1500A S/20 boph 4 hrs.
 Comp. 271 bopd

COMPLETED

County Ellis State Kansas

Sec. 15 (Blk. Twp.) 11 (Sur. Rge.) 19W Map No.

Operator Okmar

Well No. 4 Farm Fred

Elev. 1957 Location NW NW SW

330 Ft. From N Line SW

330 Ft. From W Line Quarter

1st. Report

Completion SEP 2 1953

Remarks

Nye - Contr.

Spudding Date 7-16-53

Drig. Data Oilwell TD 3495

Anhy 1263 8" @ 1273 Top. 2920

Heeb. 3139 Lens. 3179 Arb. 3491

TD 3494 5" @ 3492 DD 3495

5 boph nat. 1500 A S/ 20 boph 4 hr.

Comp. 271 bopd