


Section 15 Township 11 Range 19W

Well No. #3 Seasins (A)

Company Okmar

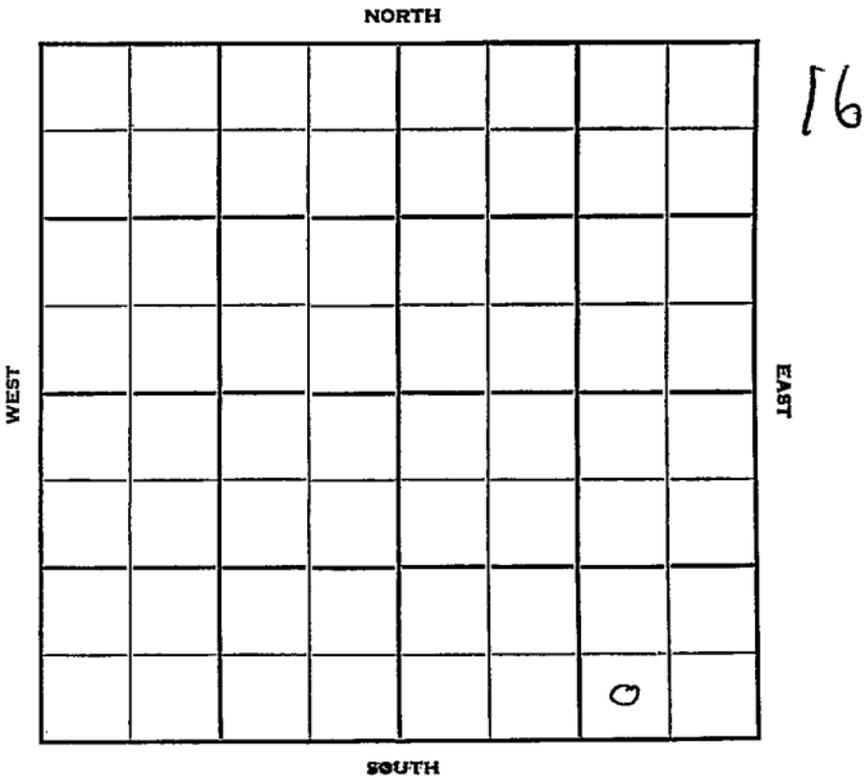

Sec. 15 Twp. 11 R. 19W

Well No. #3 Seasins (A) Farm

Okmar Company

B&R Contractor

Burnett


_____ Ft. from N. Line

330 Ft. from S. Line

990 Ft. from E. Line

_____ Ft. from W. Line

SW SE SE

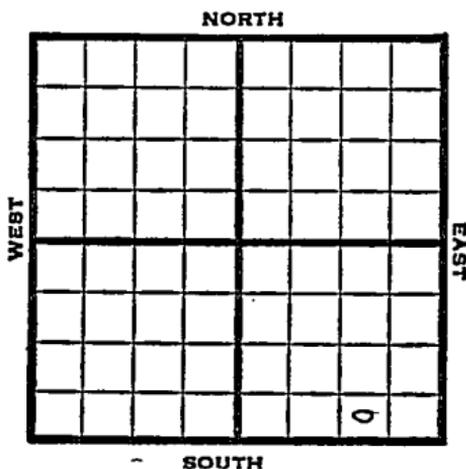

1952

Elev. 1942' REPORT

3/26

Spud 3-22-52
8" @ 1239' WOC

4/1

Dr1.g 2865 Anhy 1236'

4/9

Topeka 2894

DST 2918-33, 3/4 hr. 63' m
900#

Heeb. 3121

Lans. 3162

Cong. 3402

Simp. dol. 3461

Arb. 3484

DST 3485-90, 3/4"hr. 15' m

O# DST 3490-95 RTD 3/4 Hrs. 20' m

900# 5" @ 3486

4/23

NR

4/30

Spud 3-22-52

D & A TD 3498' 8" @ 1239'

Anhy 1236' Top 2894'

DST 2918-33 open 45 min, rec 63' mud

Heeb 3121' Lans. 3162' Cong. 3402'

Simp. dol. 3461' Arb. 3484'

DST 3485-90 open 45 min, rec 15' mud

DST 3490-95 open 45 min, rec 20' mud

5" @ 3486 CO to 3495' 500 A

lot of water & SSO TD 3498'

D & A

ABANDONED

