

Section 15 Township II Range 19W

Well No. #1 Sessin

Company B & R Drlg.

NORTH

16

WEST

EAST

0

SOUTH

Sec. 15 Twp. 11 R. 19W

Well No. #1 Sessin Farm

B & R Drlg. Company

B & R Drlg. - Contr. Contractor

Wildcat


Ft. from N. Line

330' Ft. from S. Line

330' Ft. from E. Line

Ft. from W. Line

SE SE SE

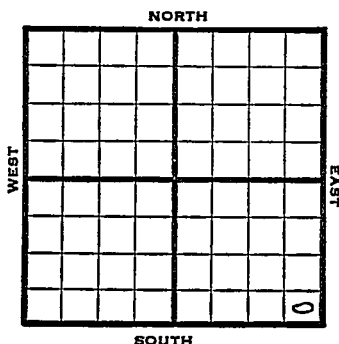

1951 Elev. 1939' REPORT

1/24 RUR

3/7 Spud 1-26-51
Oil Well TD 3464
8" @ 1107
Anhy 1325' Top. 2890
Heeb. 3116 Lans. 3160
Cong. 3402 Arb. 3455
5" @ 3455 TD 3464
FU 600' oil 4 hr 500 A
S/15 boph 1000 A Comp. 400 bopd

COMPLETED

