

Section 15 Township 11 Range 19 WWell No. # 2 Sessins "B"Company Okmar Oil

					0		

NORTH

WEST

EAST

SOUTH

2

Ellis

KANSAS ✓

Sec. 15 Twp. 11 R. 19WWell No. #2 Sessins"B" FarmOkmar Oil CompanyGlenn Nye ContractorSessins Pool

NORTH


330 Ft. from N. Line

Ft. from S. Line

Ft. from E. Line

990 Ft. from W. Line

NE NW NE

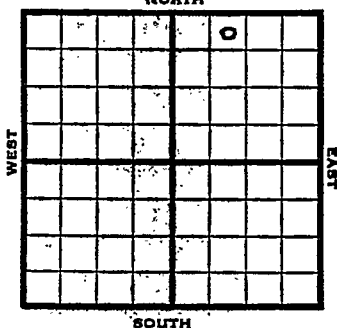

1953 Elev. 2003' REPORT

5/13 Spud 5-6-53
 Anhy 1317
 8" @ 135
 Drlg. 2668'

5/21 Top 2963 Heeb 3187 KC 3228
 Cong 3462 Simp 3507 Arb. 3531
 RTD 3534 5" @ 3532

5/28 N.R.,

6/3 "

6/10 DD 3573'
 TD 500 A s/4 boph 5 hrs. 1000 A
 POP

6/24 No report

7/1 "

7/15 Spud 5-6-53
 Oil well TD 3537 Anhy 1317
 8" @ 135 Top 2963 Heeb 3187
 KC 3228 Cong 3462 Simp 3507
 Arb. 3531 TD 3534 5" @ 3532
 DD 3537 500 A S/4 BOPH
 1000 A
 Comp. 337 BOPD

COMPLETED

J. G. McGEHEE

County Ellis State KansasSec. 15 (Blk. 11 (Sur. 19W Map No. 19W) (Twp.) (Rge.)Operator Okmar OilWell No. 2 Farm Sessins "B"Elev. 2003 Location NE NW NE

330 Ft. From N Line NE990 Ft. From W Line Quarter

1st. Report

Completion JUL 15 1953Remarks Sessins PoolGlenn Nye - Contr.Spudding Date 5-6-53Drig. Data Oil well . TD 3537Anhy 1317 8" @ 135 Top. 2963Heeb. 3187 KC 3228 Cong. 3462Simp. 3507 Arb. 3531 TD 35345" @ 3532 DD 3537 500 A S/ 4 boph1000 A Comp. 337 bopd