


Section 15 Township 11 Range 20 W

Well No. #1 Zacham

Company Carl Tood

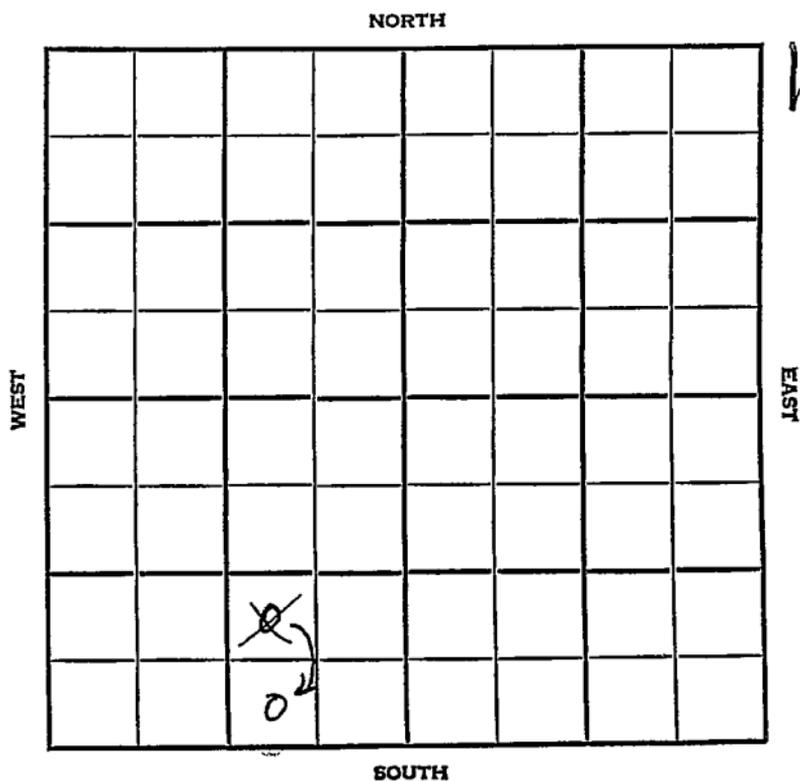

SEC.	TWP.	R.
15	11	20W


WELL NO. #1 Zachman FARM

COMPANY Carl Tood

CONTRACTOR Co Tools

Wildcat

\_\_\_\_\_ Ft. from N. Line  
330 Ft. from S. Line  
990 Ft. from E. Line  
 \_\_\_\_\_ Ft. from W. Line

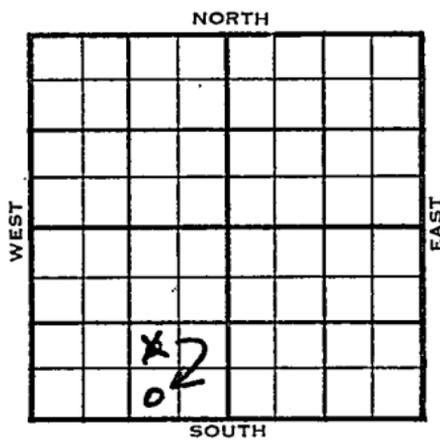

SW  
~~NE~~ SE SW

3/4 mile SDX

Sohio - FO

1955	ELEVATION	REPORT
	2099'	

- 10/12 Comm 10-10-55  
 8" @ 200/135  
 WOC
- 10-20 DST 3412-36, op 1 hr., 180' GIP, rec. 2170' clean oil, 1165/20",  
 DST 3435-55, op 1 hr., 300' GIP, rec. 120' O&GCM, 180' muddy gassy oil, 1110/20"  
 DST 3466-75, op 1 hr., rec. 50' hocm, 750#, drlg. 3505'
- 10-27 Cong. 3677, Tp. 3132  
 Simp. 3691 H. 3349  
 Arb. 3704, L. 3387  
 TD 3713,  
 5 1/2" @ 3708/150  
 WOC
- 11-3 CO DD 3730, 3 bbl. sul. wtr. ph, 12/ 3567-71, PB 3525, 36/ 3468-77, 500 A S/ 13,3 boph 3 hrs., SP 3460, 30/ 3446-# 54, 2500 A, S/ 16 boph 4 hrs.
- 11-10 Putting on pump
- 11-17 P/ 6 1/4 bfph, 13% wtr. 12 hrs.
- 11-25 No report

11-30 Comp. 216 BOPD, 10% wtr.

**COMPLETED**

County Elis Elev. \_\_\_\_\_  
 Sec. 15 Twp. 11 Rgs. 20W  
 Company Carl Tood  
 FarmName Zachman No. 1

Co.

TOPS	DEPTH	LOG	DATUM	Loc. in Sec.
Anh.				NW SE SW
Tr.				
Dg.				
Bl.				
L.				
K.C.				Geol. _____
B.K.C.				Contr. _____
Ce.				Co. tools _____
C.				
M.				Pool _____
M.				
K.				Wildcat _____
Mz.				
Ma.				
V.				
S.				
S.				
A.				
R.				
Pe.				
G.				
T.D.				

Lse.

FIRST REPORT  
 OCT 12 '55

No.

Sec.

T.

R.

Date Comm. 10-10-55 Sohio FO  
8" @ 200/135 WOC

*(Handwritten signature)*

# SCOUT TICKET DX-201

SEC. <u>15</u>	TWP. <u>11</u>	R. <u>20W</u>
----------------	----------------	---------------

WELL NO. \_\_\_\_\_

1 Zachman FARM

COMPANY \_\_\_\_\_

Carl Todd

CONTRACTOR \_\_\_\_\_

## CORRECTION


NW SE SW

\_\_\_\_\_ FT. FROM N. LINE

330 FT. FROM S. LINE

990 FT. FORM E. LINE

\_\_\_\_\_ FT. FROM W. LINE

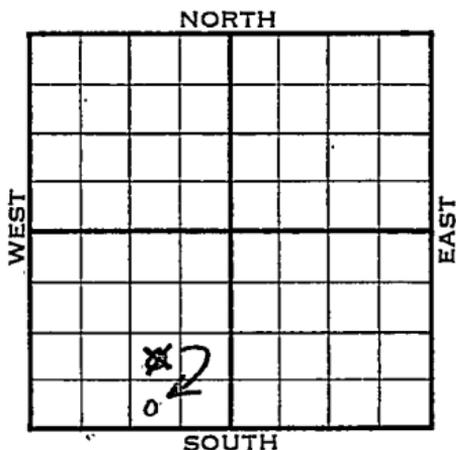

Ellis County

LOCATION

RIG UP

DRILLING AND REMARKS:

Reported

NW SE SW

<b>RECORD</b>	CASED _____ IN., _____ FT.
	SAND _____
	GAS _____
	OIL _____
<b>PRODUCTION</b>	TOTAL DEPTH _____
	1ST 24 HRS. NAT. _____
	1ST 24 HRS. AFTER SHOT _____
	GAS _____ CU. FT.
	DRY HOLE _____
ABANDONED _____	

DATE OCT 12 1955 SCOUT L.J. Harris

# SCOUT TICKET DX-201

SEC.	TWP.	R.
15	11	20W

WELL NO. \_\_\_\_\_

1 Zachman FARM

COMPANY

Carl Todd

CONTRACTOR

## CORRECTION


SW SE SW

\_\_\_\_\_ FT. FROM N. LINE

330 FT. FROM S. LINE

990 FT. FORM E. LINE

\_\_\_\_\_ FT. FROM W. LINE

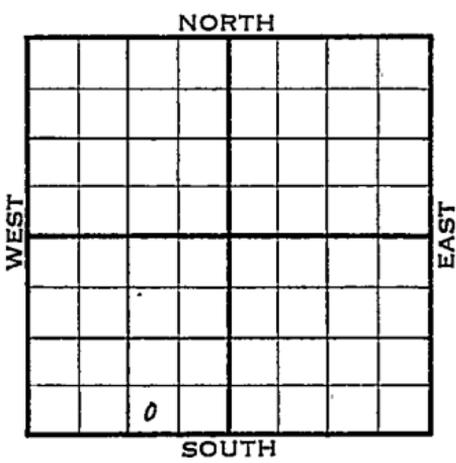

Ellis County

LOCATION

RIG UP

DRILLING AND REMARKS:

Reported

NW SE SW

<b>RECORD</b>	CASED	IN.,	FT.
	SAND	1	
	GAS		
	OIL		
<b>PRODUCTION</b>	TOTAL DEPTH		
	1ST 24 HRS. NAT.		
	1ST 24 HRS. AFTER SHOT		
	GAS		CU. FT.
	DRY HOLE		
ABANDONED			

DATE NOV 30 1955

SCOUT

County Elis Elev. 2099  
 Sec. 15 Twp. 11 Rgs. 20W  
 Company Carl Todd  
 Farm Name Zachman No. 1

Co.

Lse.

No.

Sec.

T.

R.

TOPS	DEPTH	LOG	DATUM	Loc. in Sec.
Anh.				SW SE SW
Tp.	<u>3132</u>		<u>1033</u>	
H.	<u>3349</u>		<u>1250</u>	
Tr.				
Dg.				
Bl.				
L.	<u>3387</u>		<u>1288</u>	Geol.
K.C.				Contr.
B.K.C.				
Ce.				
C.	<u>3677</u>		<u>1578</u>	Co. tools
M.				
M.				Pool
K.				
Mz.				
Mq.				
V.				
S.	<u>3691</u>		<u>1592</u>	COMPLETE
S.				
A.	<u>3704</u>		<u>1605</u>	
R.				
PE.				
G.				
TD.	<u>3713</u>			

Date Comm. : 10-10-55 NOV 30 1955

8" @ 200/135 DST 3412-36 180' GIP

rec. 2170' clean oil 1165/20"

DST 3435-55 open 1 hr. rec. 300' GIP

120' o &amp; gcm 180' muddy gassy oil

1110/20" DST 3466-75 open 1 hr.

rec. 50' hoom 750# 5 1/2" @ 3708/150

CO DD 3730 3 bsul. wtr. ph 12/ 3567-

71 PB 3525 36/ 3468-77 500 A

S/ 13.3 boph 3 hr. SP 3460 30/ 3446-54  
2500 A S/ 16 boph 4 hr. P/ 6½ bfph  
13% wtr. 12 hr Comp. 216. bopd 10% wtr.

Scout Cards	✓
Land Small Map	
Land Wall Map	
Tracings	
France Map	
Pierce Map	
Misc.	

DEC 8 1955