


Section 15 Township 11 Range 20 W

Well No. #1 Zachman

Company Todd Drlg.

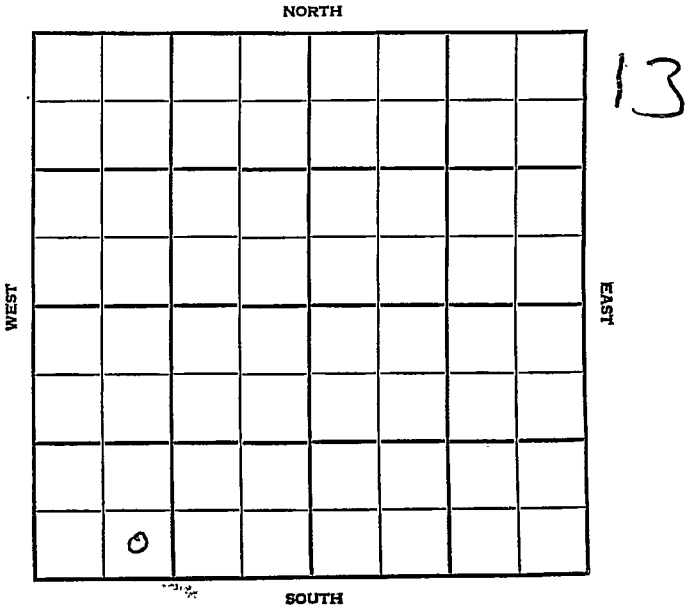


County ENIS Elev. _____
 Sec. 15 Twp. 11 Rge. 20W
 Company Tood Drlg.
 Farm Name Zachman No. 4

TOPS	DEPTH	LOG	DATUM
Anh.			
Tp.			
H.			
Tr.			
Dg.			
Bl.			
L.			
K.C.			
B.K.C.			
Ce.			
C.			
M.			
K.			
Mz.			
Me.			
V.			
S.			
S.			
A.			
R.			
PE.			
G.			
T.D.			

Loc. in Sec. SE SW SW
 Geol. _____
 Contr. Co. tools
 Pool Gromb
 FIRST REPORT
 FEB 22 '56
 0

Date Comm. 2-17-56
8th @ 190/150 drlg. 2580

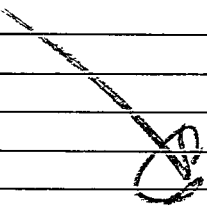

Co.
 Use.
 No.
 Sec.
 T.
 R.

County Ellis Elev. 2087
 Sec. 15 Twp. 11 Rgs. 20W
 Company Todd Drlg.
 Farm Name Zachman No. 4

TOPS	DEPTH	LOG	DATUM	Loc. in Sec.																														
Anh.				SE SW SW																														
TP.																																		
H.	<u>3343</u>																																	
Tr.																																		
Dg.																																		
Bl.																																		
L.	<u>3381</u>		<u>1294</u>	Geol.																														
K.C.				Contr.																														
B.K.C.				Co. tools																														
Ce.				Pool																														
C.				Cromb																														
M.				<table border="1"> <tr><td></td><td></td><td></td></tr> <tr><td></td><td></td><td></td></tr> <tr><td></td><td></td><td></td></tr> <tr><td></td><td></td><td></td></tr> <tr><td></td><td></td><td></td></tr> <tr><td></td><td></td><td></td></tr> <tr><td></td><td></td><td></td></tr> <tr><td></td><td></td><td></td></tr> <tr><td></td><td></td><td></td></tr> <tr><td></td><td></td><td></td></tr> </table>																														
M.																																		
K.																																		
Mz.																																		
Me.																																		
V.																																		
S.																																		
S.																																		
A.																																		
R.																																		
PE.																																		
G.																																		
TD.	<u>3623</u>			o APR 4 '56																														

Date Comm. 2-17-56
 8" @ 190/150 DST 3407-30 open 1 hr.
 rec. 100' sw 1040/20" DST 3430-50
 open 1 hr. rec. 1660' gas 660' gassy
 oil 180' muddy oil 1050/20" DST 3460-
 70 open 1 hr. rec. 30' socm 45' swcm
 1160# DST 3474-85 open 1 hr. rec.
 2160' socw 1055# DST 3570-90
 open 1 hr. rec. 46' ocm 1020/20"

Co.
Lse.
No.
Sec.
T.
R.

5 $\frac{1}{2}$ " @ 3623 CO to 3570 12/ 3561-65

2500 A PB 3500 21/ 3458-65 2500 A

S/ 42 bwph 3 hr. PB 3450 15/ 3437-40

500 A S/ 20 boph 1% wtr. 5 hr.

Comp. 341 bopd

R. G.

APR 16 1956