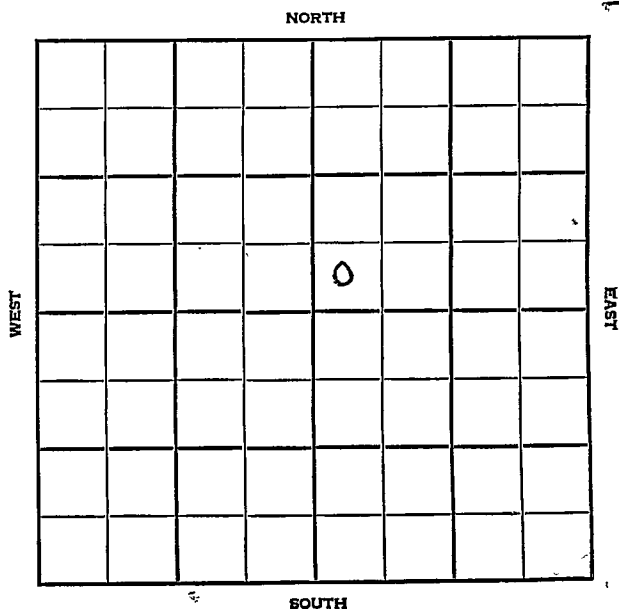


Section 15 Township 11 Range 21 WWell No. #1 MaddenCompany K & E Drlg.

Trego

KANSAS

SEC.	TWP.	R.
15 - -	11	21W

WELL NO.

#1 Madden

FARM

COMPANY

K & E Drlg.

CONTRACTOR

Co. Tools

WILDCAT


Ft. from N. Line

Ft. from S. Line

Ft. from E. Line

Ft. from W. Line

SW SW NE

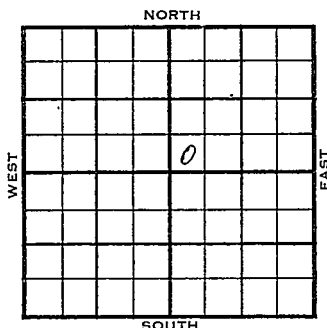

Petr. Inc. - DHM

1956	ELEVATION	REPORT
	2160	

3-14 Comm. 3-10-56
8" @ 208/150
Drlg. 2265

3-21 DST 3804-33 op $\frac{1}{2}$ hr. rec. 10' mud,
145/15"
D & A
H. 3444
Tr. 3470
L. 3486
A. 3799
TD 3833

ABANDONED

County **Trego** Elev. **2160**
 Sec. **15** Twp. **17** Rge. **21W**
 Company **K & E Drlg.**
 Farm Name **Madden** No. **1**

TOPS	DEPTH	LOG	DATUM
Anh.			
Tr.			
H.			
Tr.			
Dg.			
BL.			
L.			
K.C.			
B.K.C.			
Ce.			
C.			
M.			
M.			
K.			
Mz.			
Mq.			
V.			
S.			
S.			
A.			
R.			
Pe.			
G.			
T.D.			

Loc. in Sec.

SW SW NE


Geol.

Contr.

Co. tools

Pool

Wildcat

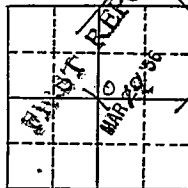

Date Comm. **3-10-56** Pet. Inc. **DHM**
8" @ 208/150 drlg. **2265** MAR 14 1956

County Trego Elev. 2160
 Sec. 15 Twp. 11N Rge. 21W
 Company K & E Drilg.
 Farm Name Madden No. 1

TOPS	DEPTH	LOG	DATUM	Loc. in Sec.
Anh.				SW SW NE
Tp.				
H.	<u>3444</u>			
Tr.	<u>3470</u>			
Dg.				
BL.				
L.	<u>3486</u>		<u>1326</u>	Geol.
K.C.				Contr.
B.K.C.				Co. tools
Ce.				Pool
C.				Wildcat
M.				
M.				
K.				
Mz.				
Me.				
V.				
S.				
S.				
A.	<u>3799</u>		<u>1639</u>	
R.				
Pe.				
G.				
T.D.	<u>3833</u>			

Date Comm. 3-10-56 MAR 21 1956

8" @ 208/150 DST 3804-33 open $\frac{1}{2}$ hr.

rec. 10¹ mud 145/15"

D & A

ABANDONED