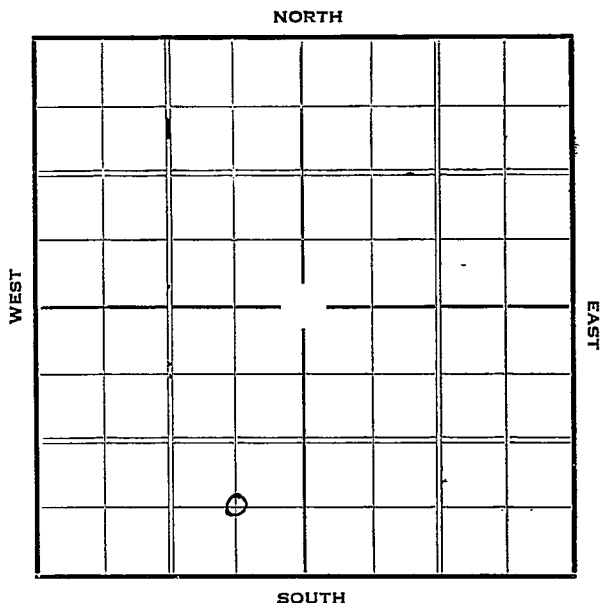



Trego

KANSAS

Section 15 Township 11 Range 23-WWell Number 1 LemkeCompany Watchorn et al

KANSAS**Trego**Sec. 15 Twp. 11 R. 23-WWell No. #1 Limke FarmWatchorn et al Company Ft. from N. Line660 Ft. from S. Line660 Ft. from E. Line Ft. from W. Line

Elev. 2272

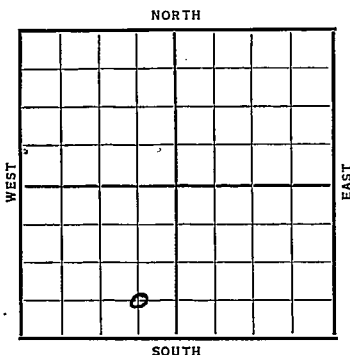

Date	REPORT
1936	O. W. D. D
11/18	Rigging up
11/27	10" @ 93'. Drlg. 1600'.
12/3	Anhydrate 1725'. Drlg. 2692'
12/10	Kansas City 3494'. 7" @ 3493'.
	T. D. 3503'. WOG.
12/17	RUST.
1937	
1/6	Kansas City Lime 3494'.
	T. D. 3503'.
	Pump 656 Nat.
	COMPLETED
	O. W. D. D
1937	
8/4	Old T.D. 3503'.
	Deepened to 3510' T.D.
	1000' oil. Testing.
	OVER

1937

8/11 Old well deepened from 3503-
3510' and completed for old
pot. of 656 bbls.
T.D. 3510'.

COMPLETED

KANSAS

Map No. 69 Sec. 15 Twp. 11 R. 23WWell No. 1 LumberHatborn & Co Company

Contractor

SECTION PLAT

112 Ft. from N. Line660 Ft. from S. Line660 Ft. from E. Line Ft. from W. Line

FIRST REPORT

Location Rig up

Drilling and Remarks:

Rigging up.
[Signature]

RECORD

Cased in., ft.Sand 1/2Gas 2 1/2Oil Total Depth

PRODUCTION

1st 24 hrs. Nat. 1st 24 hrs. after shot Gas Cu. Ft.Dry Hole Abandoned

Date

NOV 18 1936

19

S. J. LEWIS Scout

KANSAS

Map No. 69 Sec. 15 Twp. 11 R. 23WWell No. 1 Lemke.Watson & Gal Company

Contractor

SECTION PLAT

	0		

 Ft. from N. Line660 Ft. from S. Line660 Ft. from E. Line Ft. from W. Line

COMPLETED

Location Rig up

Drilling and Remarks:

KCL 3494Pump 656 Nat.

RECORD

Cased in., ft.Sand Gas Oil Total Depth 3503

PRODUCTION

1st 24 hrs. Nat. 1st 24 hrs. after shot Gas Cu. Ft.Dry Hole Abandoned

Date

JAN 6 1937 19

S. J. LEWIS Scout

Trego **KANSAS**Map No. *69* Sec. *15* Twp. *11* R. *23*^WWell No. *1 - Lemke**Watchorn* Company

Contractor

FIRST REPORT

SECTION PLAT

	0		

_____ Ft. from N. Line

660 Ft. from S. Line*660* Ft. from E. Line

_____ Ft. from W. Line

- *OWDD* -

Location _____

Rig up _____

Drilling and Remarks:

*OTO 3503**deepened to 3510 ft.**1000" oil
testing*

RECORD

Cased _____ in., _____ ft.

Sand _____

Gas _____

Oil _____

Total Depth _____

PRODUCTION

1st 24 hrs. Nat. _____

1st 24 hrs. after shot _____

Gas _____ Cu. Ft.

Dry Hole _____

Abandoned _____

Date

AUG 4 - 1937

19

H. D. Hatfield

Scout

Trego KANSAS

Map No. 69 Sec. 15 Twp. 11 R. 23^WWell No. 1- LemkeWatchorn Company

Contractor

COMPLETED

SECTION PLAT

 Ft. from N. Line660 Ft. from S. Line660 Ft. from E. Line Ft. from W. Line

	0		

Location Rig up

Drilling and Remarks:

old well deepened
 From 3503-3510
 and completed
 For old pot. of
 656 bbls

RECORD

Cased in., ft.Sand Gas Oil Total Depth 3510

PRODUCTION

1st 24 hrs. Nat. 1st 24 hrs. after shot Gas Cu. Ft.Dry Hole Abandoned

Date

AUG 11 1937H. D. Hatfield Scout