


Section 15 Township 11 Range 23-W

Well Number 1 Lemke

Company Watchorn O&G

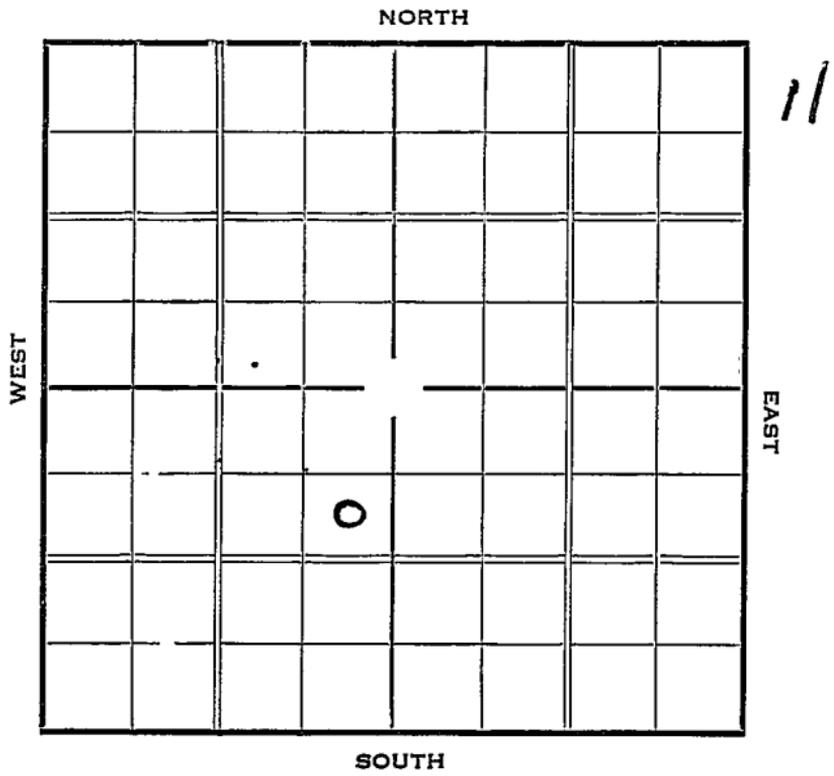


Sec. 15 Twp. 11 R. 23-WWell No. #1 Lemke Farm
Watchorn O & G Company990 Ft. from N. Line

_____ Ft. from S. Line

330 Ft. from E. Line

_____ Ft. from W. Line

Elev. 2251

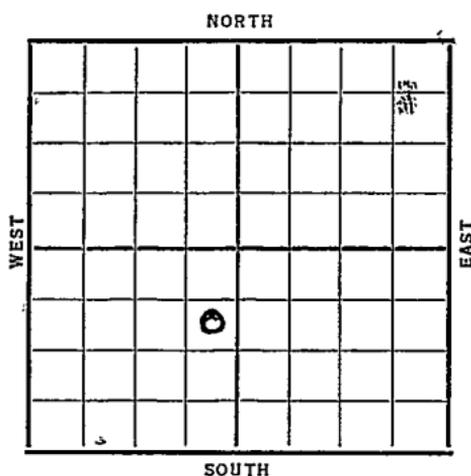

Date	REPORT
1937	
3/24	Location
4/2	" "
4/8	R.O.G.
4/16	10" @ 111 WOC
4/23	Anhydrate 1717'. Drlg. 2512'
4/30	T.K.C. 3480'.
	Saturated core 3480-82'.
	7" @ 3479'. T.D. 3482'.
	WOC.
5/7	RUST.
5/14	$\frac{1}{2}$ bbl. oil per hr. 3488'.
	T.D. 3515'. 2300' water.
	No increase in oil. C.O.
5/21	5" @ 3520'. Drlg. 3591'.
5/28	T.D. 3720'. U.R. 5".
6/4	" " " "
6/11	5" @ 3715'. T.D. 3755'.
	Fishing.
6/19	5" @ 3747'. Drlg. 3790'.
6/25	T.D. 3825' Fsg.

OVER

1937

7/2 5" @ 3814'. T.D. 3865' Fsg.

7/9 " " " " "

7/16 Drlg. 3875'.

7/23 5" @ 3814'. Drlg. 3920'.

7/30 Sil. 3692-76' T.D.

9 B.W.P.H. P.B. to K.C.

8/6 " " " " "

8/13 " " " " "

8/20 " " " " "

8/28 " " " " "

9/3 Sil. 3962-76' T.D.

9/10 " " " " "

9/17 T.D. 3976' SD.

9/24 " " " "

9/29 5" @ 3814'.

Sil. 3962'.

T.D. 3976'.

ABANDONED

KANSAS *Trego*Map No. *69* Sec. *15* Twp. *11* R. *23W*Well No. *1 Lemke**Watchorn O & S* Company

Contractor

SECTION PLAT

990 Ft. from N. Line

_____ Ft. from S. Line

330 Ft. from E. Line

_____ Ft. from W. Line

FIRST REPORT

Location

Rig up _____

Drilling and Remarks:

RECORD

Cased _____ in., _____ ft.

Sand _____

Gas _____

Oil _____

Total Depth _____

PRODUCTION

1st 24 hrs. Nat. _____

1st 24 hrs. after shot _____

Gas _____ Cu. Ft.

Dry Hole _____

Abandoned _____

Date

MAR 24 1937

19

S. J. LEWIS Scout

Map No. 69 Sec. 15 Twp. 11 R. 23WWell No. 1-LenkeWatchorn O & G Company

Contractor

ABANDONED

SE NE SW

990 Ft. from N. Line

Ft. from S. Line

330 Ft. from E. Line

Ft. from W. Line

SECTION PLAT

		0	

Location _____

Rig up _____

Drilling and Remarks:

RECORD

Cased 5 in., 3814 ft.Sand 511 3962

Gas _____

Oil _____

Total Depth 3976

PRODUCTION

1st 24 hrs. Nat. _____

1st 24 hrs. after shot _____

Gas _____ Cu. Ft.

Dry Hole _____

Abandoned _____

Date

SEP 29 1937 19 Y. D. Hatfield Scout

D. & A.