

Section 15 Township II Range 24W

Well No. #1 Owens

Company Elreco & Rock Island Ref. Co.

NORTH

							0

9

WEST

EAST

SOUTH

Sec. 15 Twp. 11 R. 24 W

Well No. # 1 Owens Farm

Elreco & Rock Island Ref. Company

Prime Drlg. Contractor


Wildcat

330 Ft. from N. Line

Ft. from S. Line

330 Ft. from E. Line

Ft. from W. Line

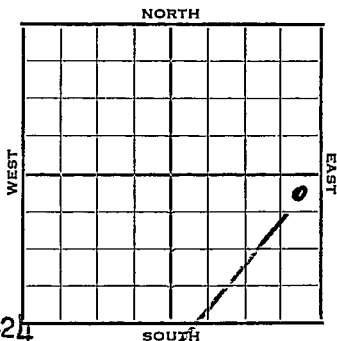

NE NE SE

MCPS has SE/4 of 21-11-24

1953 Elev. 2395' REPORT 3/4 M 160 AC.

7/8 RURT
 7/23 Top 3500' Heeb 3730' Tor 3751
 Lans 3755
 DST 3924-48, open 1 hr rec 9' mud 150#
 B KC 4001 Marm. 4006 Cong 4226
 Miss 4306 Viola 4366 Arb. 4497
 TD 4544 Ran Schl D & A (Ltr-McGehee)

7/22 Spud 7-7-53
 D & A TD 4544' 8" @ 293
 Anhy 1980 Top 3500 Heeb 3730
 Tor. 3751 Lans 3755
 DST 3924-48 open 1 hr rec 9' mud 150#
 B KC 4001 Marm 4006 Cong 4226
 Miss 4306 Gilmore City 4375
 Viola 4366 Arb. 4497
 TD 4544 D & A

ABANDONED

4497
 2395

 210
 42
 37
 1

