


Section 15 Township 11 Range 17-W

Well Number #2 Bemis "B"

Company Margay Oil

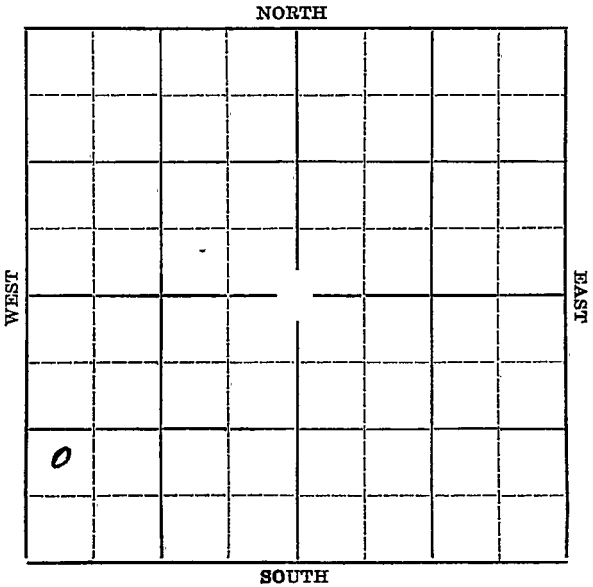

Map No. KANSAS Sec. 15 Twp. 11 R. 17W

Well No. #2 Bemis "B" Farm

Margay Oil Company


\_\_\_\_\_ Ft. from N. Line

990' Ft. from S. Line

\_\_\_\_\_ Ft. from E. Line

330' Ft. from W. Line

Elev. 1894

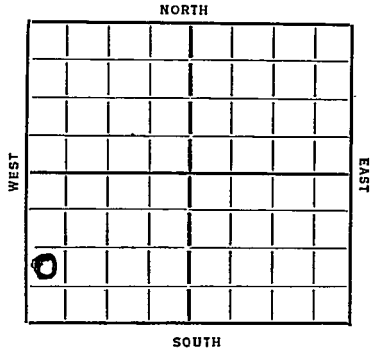

Date 1936

REPORT

- 7/15 Rigging up rotary.
- 7/23 10" @ 1108'. Waiting on cement.
- 7/30 Drlg. 2361'.
- 8/6 Drlg. 2890'.
- 8/13 Simpson 3395'. Drlg. 3409'.
- 8/20 Siliceous 3408'. 6" @ 3409'. RUST.
- 8/27 TD 3423'. Pump 69 bbls of oil per hour.
- 9/2/36 Sil. 3408'.
- T.D. 3423'.
- Potential 1671 bbls of oil nat.

**COMPLETED**

Map No. 71 Sec. 15 Twp. 11 R. 17W

Well No. 2. Bemis "B"

Margery Oil Company

[Signature] Contractor

**SECTION PLAT**

0			

\_\_\_\_\_ Ft. from N. Line

990 Ft. from S. Line

\_\_\_\_\_ Ft. from E. Line

330 Ft. from W. Line

**COMPLETED**

Location \_\_\_\_\_

Rig up \_\_\_\_\_

Drilling and Remarks:

Sil 3408

Ps 8 1671

Nat.

**RECORD**

Cased \_\_\_\_\_ in., \_\_\_\_\_ ft.

Sand \_\_\_\_\_

Gas \_\_\_\_\_

Oil \_\_\_\_\_

Total Depth 3423

**PRODUCTION**

1st 24 hrs. Nat. \_\_\_\_\_

1st 24 hrs. after shot \_\_\_\_\_

Gas \_\_\_\_\_ Cu. Ft.

Dry Hole \_\_\_\_\_

Abandoned \_\_\_\_\_

Date

SEP 2 1936 19

S. J. LEWIS Scout

