


Section 15 Township 11 Range 17-W

Well Number #3-Bemis "B"

Company Margay Oil

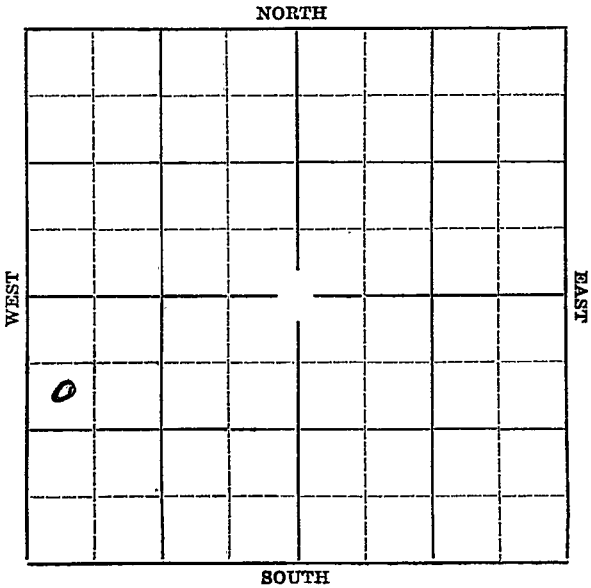

Sec. 15 Twp. 11 R. 17W

Well No. #3 Bemmis "B" Farm

Margay Oil Company


990' Ft. from N. Line

_____ Ft. from S. Line

_____ Ft. from E. Line

330' Ft. from W. Line

Elev. 1879

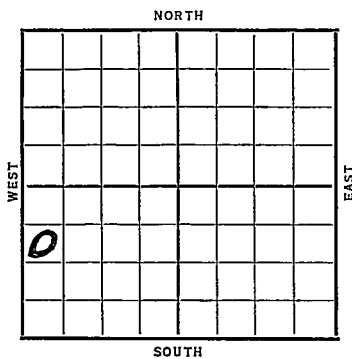

~~1936~~

REPORT

8/26 Cellar.

9/3 Rigg ng.

9/10 Drlg. 2950'.

9/18 Drlg. 3225'.

9/24 Shut down.

10/1 Siliceous 3393'. Run 7".

10/8 T.D. 3401'. 2000 gallons of acid.

No test.

~~XXXXXXXXXXXXXXXXXXXX~~

10/14/36-Sil. 3393'.

T.D. 3401'.

2000 gallons of acid.

Potential 1196 bbls of oil.

COMPLETED

Map No. 71 Sec. 15 Twp. 11 R. 12W

Well No. 3 Bemis "B"

Morgan Oil Company

[Signature] Contractor

SECTION PLAT

0			

990 Ft. from N. Line

_____ Ft. from S. Line

_____ Ft. from E. Line

1231 Ft. from W. Line

FIRST REPORT

Location _____

Rig up _____

Drilling and Remarks:

C & Har

RECORD

Cased _____ in., _____ ft.

Sand _____

Gas _____

Oil _____

Total Depth _____

PRODUCTION

1st 24 hrs. Nat. _____

1st 24 hrs. after shot _____

Gas _____ Cu. Ft.

Dry Hole _____

Abandoned _____

Date

AUG 26 1936 19

S. J. LEWIS

Scout

KANSAS

Map No. 71 Sec. 15 Twp. 11 R. 17W

Well No. 3 "Benjie B"

Margay Oil Company

[Signature] Contractor

SECTION PLAT

0			

990 Ft. from N. Line

_____ Ft. from S. Line

_____ Ft. from E. Line

320 Ft. from W. Line

COMPLETED

Location _____

Rig up _____

Drilling and Remarks:

Sec 63393
2000 acid
P 8 1196

RECORD

Cased _____ in., _____ ft.

Sand _____

Gas _____

Oil _____

Total Depth 3401

PRODUCTION

1st 24 hrs. Nat. _____

1st 24 hrs. after shot _____

Gas _____ Cu. Ft.

Dry Hole _____

Abandoned _____

Date

OCT 14 1936 19

S. J. LEWIS Scout