
Elbe

Form 51—5M—3-35—Mid-West

Map No. KANSAS Sec. 15 Twp. 11 R. 17W

Well No. 2- Bemis Farm

Marzay Oil Co et al Company

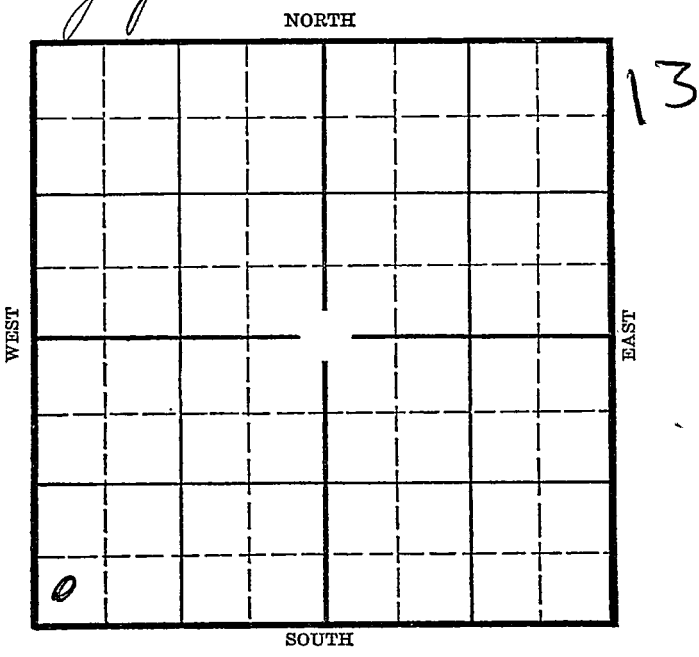

Location

Drilling Remarks

Rig Up

Drilling Remarks

RECORD

Cased ____ in. ____ ft.

Sand

Gas

Oil

Total Depth

PRODUCTION

1st 24 hrs. Nat.

1st 24 hrs. after shot

Gas ____ cu. ft.

Dry Hole

Abandoned


Form 252-A
5M 7-34 MPC

Ellis

Map No. KANSAS Sec. 15 Twp. 11 R. 17W

Well No. 2- Berges Farm

Marguy Oil Co etal Company

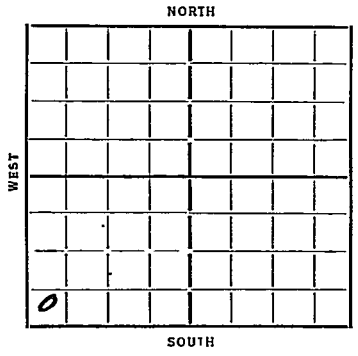

____ Ft. from N. Line

330 Ft. from S. Line

____ Ft. from E. Line

330 Ft. from W. Line

Elev. 1867

Date 1937	REPORT
11/20	Rotary.
11/29	Rig
12/6	Dly 140 20" 95 - -
12/13	16" 405 TD 575 WR. . .
12/19	WR 15" 760
12/26	—
12/26	SD 1212
1/10	16" 815 T Anhy 1083
	10" 2239 TD WOC
1/17	10" WR to 2273 TD 2598
	Rung 8"
1/24	8" 2598
1/31	—
2/7	8" 2897 1500' OIH 2990-95
	Dly 3040
2/14	Top Dev. 3075 to 3096
	3 Bailers wtr 3110
	TD 3113 Rig.
2/21	6" 3090 TD 3113 2500' Oil SD.
2/28	6" 3105 TD 3113 Rig Bit

(OVER)

3/6 Abo wtr 3157-67
Abo Oil 3167-75
Dly 3212 6" 3194

3/13 T Oil 3380
Abo Oil 3382 TD
filled 2800' Oil 30 Min
HFO & Rung 5"

3/20 5"- 3378 WOC

3/27 Testing.

4/2- --

4/10-T.D. 3382' Pumping 35 bbls. per hr

4/15 Oil 3380
TD 3382
pump 1353 Bbls Nat.

COMPLETED

COMMENCED

Form 26-1M Blks.—9-28

KANSAS


Map No. 71 Sec. 15 Twp. 11 R. 17W

Well No. 2 Bemis

Marquay Oil Company

S J Contractor

SECTION PLAT

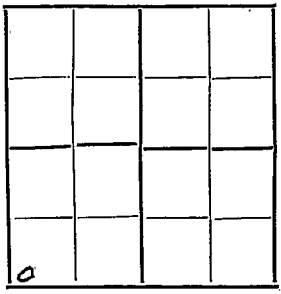

Ft. from N. Line

330 Ft. from S. Line

Ft. from E. Line

330 Ft. from W. Line

COMPLETED

Location

Rig up:

Drilling and Remarks:

Oil 3380

Pump-185 BbL Nat.

RECORD

Cased in., ft.

Sand

Gas

Oil

Total Depth 3382

PRODUCTION

1st 24 hrs. Nat.

1st 24 hrs. after shot

Gas Cu. Ft.


Dry Hole

Abandoned

Date

APR 15 1936 192

S. J. LEWIS Scou

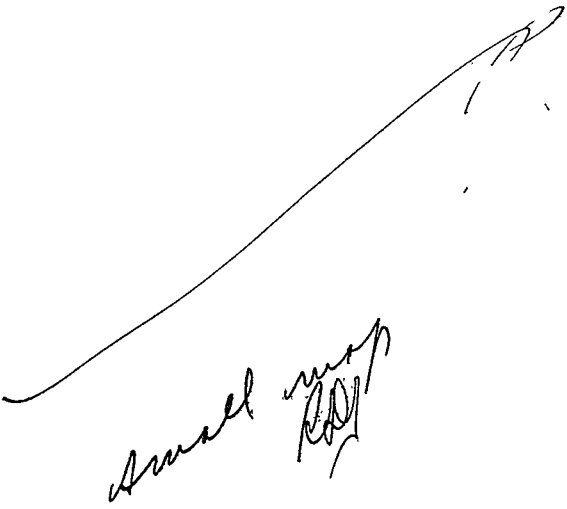

Returned	
Cards	
Tracing	
France Map	
Borough Map	
Atlas Map	
Borough Plat Book	
Atlas Plat Book	

Form 26 AM Blks 29-28

KANSAS

Map No. 71 Sec. 15 Twp. 11 R. 17W

Well No 2-Bemis

Margay Oil Co Etal Company

Contractor

FIRST REPORTS


Ft. from N. Line

330 Ft. from S. Line

Ft. from E. Line

330 Ft. from W. Line

SECTION PLAT

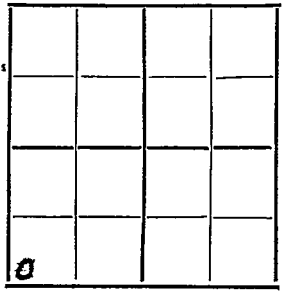

Location

Rig up

Drilling and Remarks:

Rig n

RECORD

Cased in., ft.

Sand

Gas

Oil

Total Depth

PRODUCTION

1st 24 hrs. Nat.

1st 24 hrs. after shot

Gas Cu. Ft.

Dry Hole

Abandoned

Date

11-20-35 192

OBVAL MANSCH 3K Scout

Sam- Our tracing does not show #1 Well SW SEC 15 T.11S; R.17W. Please advise,

Pittman
Eng. Dept.

#1-Well located in SW/c 16

