


Section.....15.....Township.....11.....Range.....17-W

Well Number.....#2 Richmond.....

Company.....Lebow et al.....

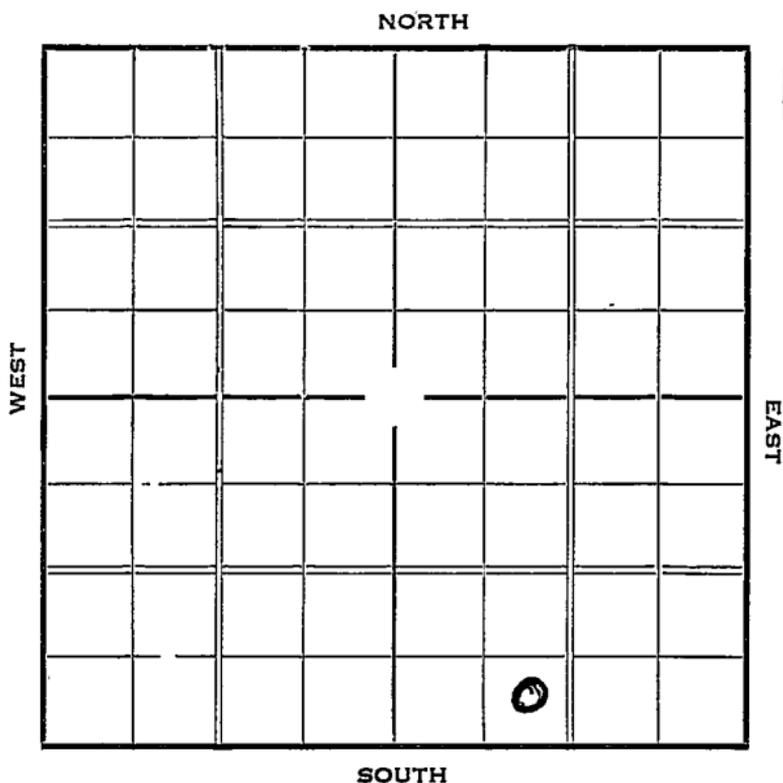

1937

10/22 Sil. 3424' (Corrected)
Pumped 315 B.O. 24 hrs.
2000 acid.

10/27 7" @ 3392'.
5" liner 3424'.
Sil. 3424'.
T.D. 3441'.
4000 acid.
Potential 2099 bbls.

COMPLETED

Ellis KANSAS

Map No. _____ Sec. 15 Twp. 11 R. 17^wWell No. 2-RichmondLebow et al Company

Contractor _____

FIRST REPORT SECTION PLAT

_____ Ft. from N. Line

330 Ft. from S. Line

_____ Ft. from E. Line

990 Ft. from W. Line

			0

Location _____

Rig up _____

Drilling and Remarks:

RECORD

Cased _____ in., _____ ft.

Sand _____

Gas _____

Oil _____

Total Depth _____

PRODUCTION

1st 24 hrs. Nat. _____

1st 24 hrs. after shot _____

Gas _____ Cu. Ft.

Dry Hole _____

Abandoned _____

Date

JUN 30 1937 19H. D. Hatfield Scout

Map No. _____ Sec. 15 Twp. 11 R. 17W

Well No. 2 Richmond

Lebow etal Company

Contractor

COMPLETED

SE SW SE

SECTION PLAT

			0

_____ Ft. from N. Line

330 Ft. from S. Line

_____ Ft. from E. Line

990 Ft. from W. Line

Location _____

Rig up _____

Drilling and Remarks:

4000 acid

Pat - 2099

7" RECORD 3392
Cased **5" LIner** in., **3424** ft.

Sand *Si/ 3424*

Gas _____

Oil _____

Total Depth 3441

PRODUCTION

1st 24 hrs. Nat. _____

1st 24 hrs. after shot _____

Gas _____ Cu. Ft.

Dry Hole _____

Abandoned _____

Date

OCT 27 1937

H. D. Hatfield

19

Scout