


Section 15 Township 11 Range 17W

Well No. #1 Richmond

Company Aylward Drlg.

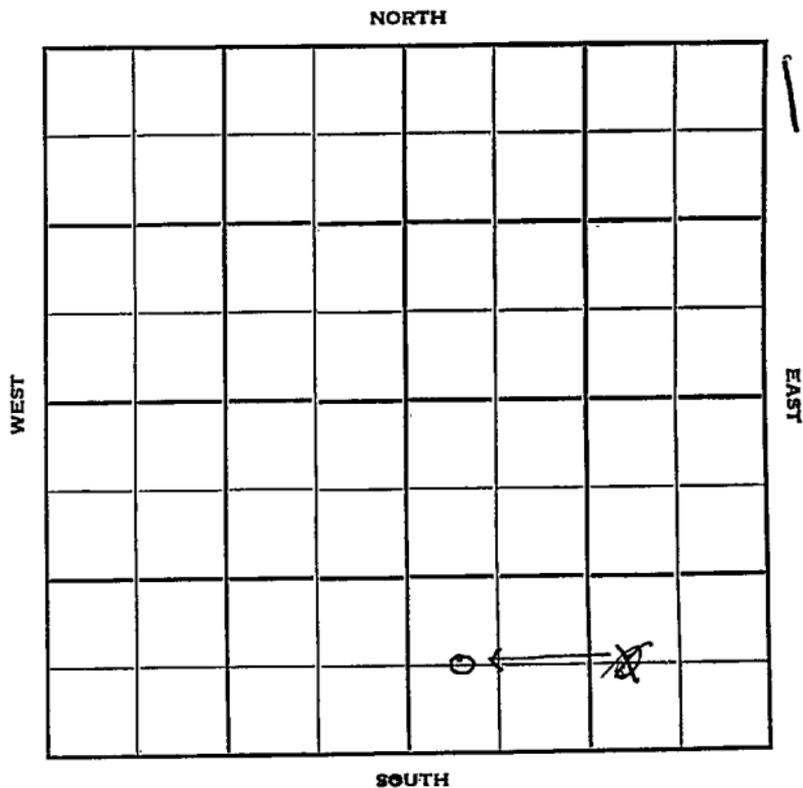

Sec. 15 Twp. 11 R. 17W

Well No. #1 Richmond Farm

Aylward Drlg. Company

Contractor


Bemis Pool

         Ft. from N. Line

660 Ft. from S. Line

~~990~~ Ft. from E. Line

330 Ft. from W. Line

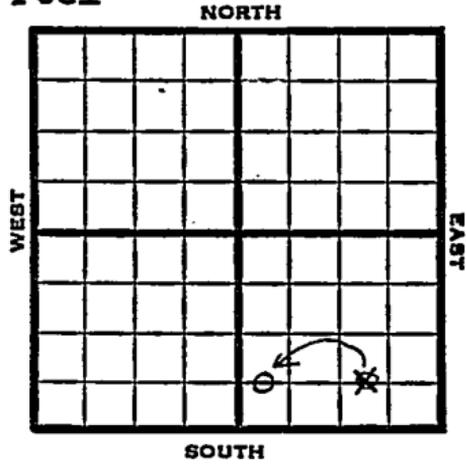

~~C W L SE SE~~  
C W/2 SW SE

1951 Elev. 1926' REPORT

10/3

Location

10/24

Spud 10-7-51  
 D&A TD 3462'  
 8" @ 153  
 Anhy 1149 Heeb. 3094  
 Lans. 3141 Cong. 3414  
 Simp. 3440 Arb. 3459  
 DST 3460-62 open 2 hr. rec.  
 6' OCM 1500' GCSW  
 TD 3462  
 D&A

**ABANDONED**



**CORRECTION**

Map No. \_\_\_\_\_ Sec. 15 Twp. 11 R. 17W

Well No. 1 Richmond

Alward Drlg. \_\_\_\_\_ Company

\_\_\_\_\_  
Contractor

**C W/2 SW SE**

**SECTION PLAT**

\_\_\_\_\_ Ft. from N. Line

660 Ft. from S Line

\_\_\_\_\_ Ft. from E. Line

330 Ft. from W. Line

		o.	

**Ellis County, Kansas**

**RECORD**

Location \_\_\_\_\_

Cased \_\_\_\_\_ in., \_\_\_\_\_ ft.

Rig up \_\_\_\_\_

Sand \_\_\_\_\_

Drilling and Remarks:

Gas \_\_\_\_\_

**Reported**

Oil \_\_\_\_\_

**C W/2 SE SE**

Total Depth \_\_\_\_\_

**PRODUCTION**

1st 24 hrs. Nat. \_\_\_\_\_

1st 24 hrs. after shot \_\_\_\_\_


Gas \_\_\_\_\_ Cu. Ft.

Dry Hole \_\_\_\_\_

Abandoned \_\_\_\_\_

Date \_\_\_\_\_

**J. E. Tyra**

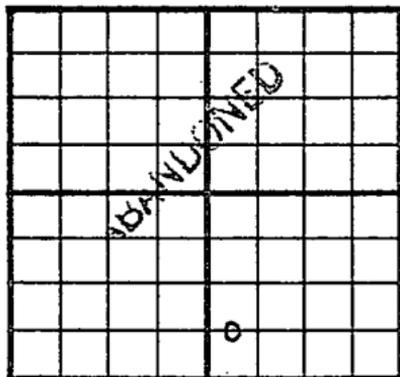County Ellis State KansasSec. 15 (Blk. Twp.) 11 (Sur. Rge.) 17W Map No.Operator Aylward Drlg.Well No. 1 Farm RichmondElev. 1926 Location C W L SW SE660 Ft. From S Line SE330 Ft. From W Line Quarter

Ist. Report

Completion OCT 24 1951Remarks Bemis PoolSpudding Date 10-7-51Drlg. Data D & A TD 34628" @ 153 Anhy 1149 Heeb. 3094Lans. 3141 Cong. 3414 Simp. 3440Arb. 3459 DST 3460-62 open 2 hr.Rec. 6' ocm 1500' gcsw TD 3462D & A

J. E. TYRA