


KANSAS Ellis County

Section 15 Township 11 Range 17W

Well No. #1 Richmond

Company Texas

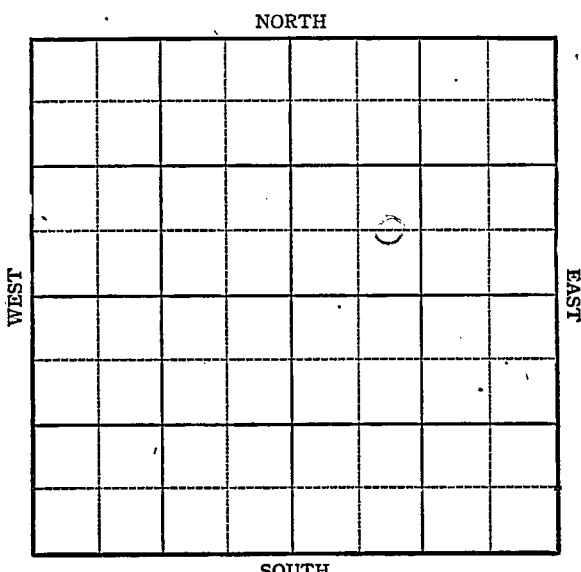

KANSAS

Ellis County

Sec. 15 Twp. 11 R. 17W

Well No. #1 Richmond Farm

Texas

Company


Bemis

Ft. from N. Line

660 Ft. from S. Line

Ft. from E. Line

990 Ft. from W. Line

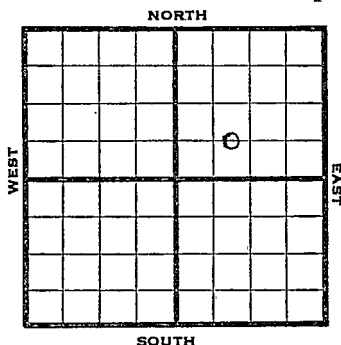

C E D SW NE

1944

R E P O R T

10/11 Cellar

10/18 Drlg. 425'

10/25 anhy 1140

9 "@ 1147

Drlg. 27 38

11/2 Drlg. 3492

11/8 Lans 3170

BKG 3380

Cong. 3406

Simp. 3475

Arb. 3490

TD 3540

ABANDONED

KANSAS


Pool Name BemisMap No. 77 Sec. 15 Twp. 11 R. 17WWell No. 1 RichmondTexas Company

FIRST REPORT

Contractor

C E L S W N E

SECTION PLAT

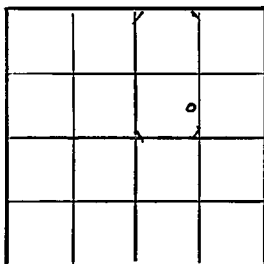

Ft. from N. Line

660

Ft. from S. Line

Ft. from E. Line

990

Ft. from W. Line

Ellis County

RECORD

Location _____

Cased _____ in., _____ ft.

Rig up _____

Sand _____

Drilling and Remarks:

Gas _____

Cellar

Oil _____

Total Depth _____

• PRODUCTION

1st 24 hrs. Nat. _____

1st 24 hrs. after shot _____

Gas _____ Cu. Ft.

Dry Hole _____

Abandoned _____

Date

OCT 11 1944

19

S. J. LEWIS Scout

Pool Name BemisMap No. 71 Sec. 15 Twp. 11 R. 17WWell No. 1 RichmondTexas CompanyABANDONED Contractor

C E L S W N E

SECTION PLAT

		o	

 Ft. from N. Line660 Ft. from S. Line Ft. from E. Line990 Ft. from W. LineEllisLocation Rig up

Drilling and Remarks:

Line 3170BKC 3380Long 8406Smj 3475Ar 3490

RECORD

Cased in., ft.Sand Gas Oil Total Depth 2540

PRODUCTION

1st 24 hrs. Nat. 1st 24 hrs. after shot Gas Cu. Ft.Dry Hole Abandoned

Date

NOV 8 1944 19S. J. LEWIS Scout