
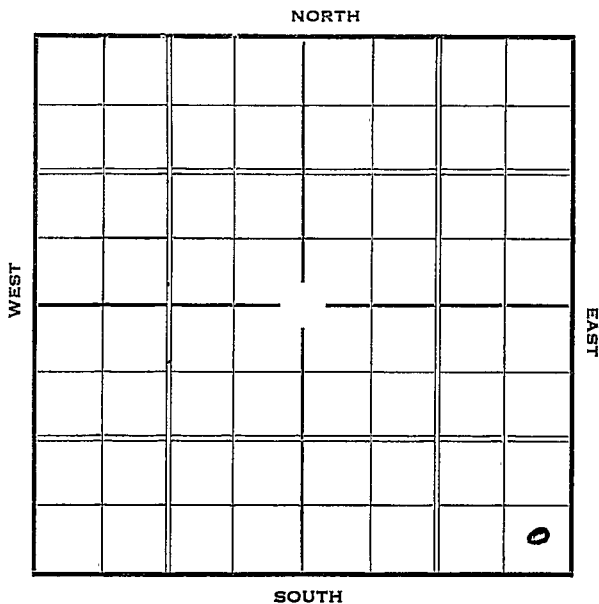


Section 15 Township 11 Range 17-WWell Number #2 RichmondCompany Blackwell O & G

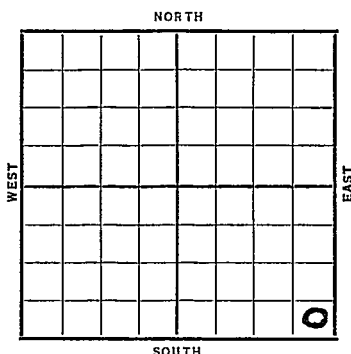

Pot. 1693 bbls.

Ellis **KANSAS**Map No. _____ Sec. 15 Twp. 11 R. 17WWell No. 2 RichmondBlackwell O & G Company_____
Contractor**FIRST REPORT****SE/C**_____
Ft. from N. Line330
Ft. from S. Line330
Ft. from E. Line_____
Ft. from W. Line**SECTION PLAT**

			0

Location X

Rig up _____

Drilling and Remarks:

RECORD

Cased _____ in., _____ ft.

Sand _____

Gas _____

Oil _____

Total Depth _____

PRODUCTION

1st 24 hrs. Nat. _____

1st 24 hrs. after shot _____

Gas _____ Cu. Ft.

Dry Hole _____

Abandoned _____

Date

OCT 13 1937 19 H. D. Hatfield Scout

Ellis

KANSAS

Map No. 71 Sec. 15 Twp. 11 R. 17WWell No. 2 Richmond
Blackwell O & G Company

Contractor

COMPLETED

SE/C

 Ft. from N. Line,330 Ft. from S. Line330 Ft. from E. Line Ft. from W. Line

SECTION PLAT

			0

Location Rig up

Drilling and Remarks:

*2000 acid**LOT-1693*

RECORD

Cased 7 in., 3396 ft.~~Sand~~ 5.1 3396Gas Oil Total Depth 3410

PRODUCTION

1st 24 hrs. Nat. 1st 24 hrs. after shot Gas Cu. Ft.Dry Hole Abandoned

Date

DEC. 8 - 1937 19 H. D. Hatfield Scout