


Section 15 Township 11 Range 17-W

Well Number #1 Richmond

Company Blackwell O&G

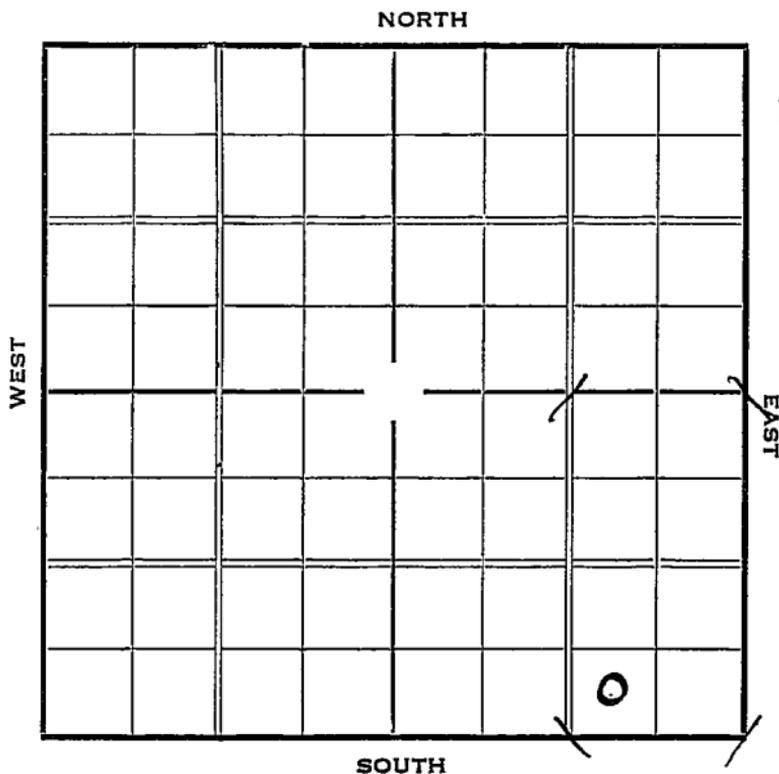


16

Sec. 15 Twp. 11 R. 17-WWell No. #1 Richmond FarmBlackwell O&G Company

_____ Ft. from N. Line

330' Ft. from S. Line990' Ft. from E. Line

_____ Ft. from W. Line

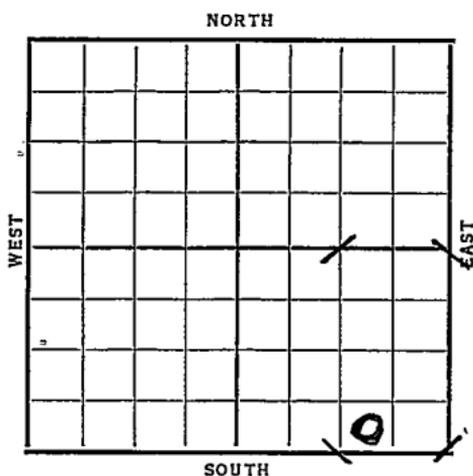

Date	REPORT
1937	
7/21	Location
7/30	B. R.
8/6	S. H.
8/13	10" @ 812'. Anhy 1095'.
	Drlg. 2128'.
8/20	Drlg. 3397'.
8/28	Sil. & 7" @ 3397'.
	T.D. 3398'. RUST.
9/3	1st oil 3413'. 150' 1½ hrs.
	T.D. 3416'. 300' oil 1 hrs.
	1000' oil 5 hrs. 2000 acid.
	Swab 92 B.O. 2 hrs.
	Reacidizeing.
9/10	Pot. 1195 bbls. Will retest.
9/17	" " " " "
9/24	" " " " "
	OVER

1937

9/29

7" @ 3397'.

Sil. 3397'.

T.D. 3416'.

2000 acid.

Pot. 1195 bbls.

COMPLETED

Ellis

Map No. 71 Sec. 15 Twp. 11 R. 17^WWell No. 1 - RichmondBlackwell O & G Company

Contractor

FIRST REPORT

SECTION PLAT

 Ft. from N. Line330 Ft. from S. Line990 Ft. from E. Line Ft. from W. Line

Location Rig up

Drilling and Remarks:

RECORD

Cased in., ft.Sand Gas Oil Total Depth

PRODUCTION

1st 24 hrs. Nat. 1st 24 hrs. after shot Gas Cu. Ft.Dry Hole Abandoned

Date

JUL 21 1937

H. D. Hatfield

Scout

Map No. _____ Sec. 15 Twp. 11 R. 17WWell No. 1-RichmondBlackwell O&G Company

Contractor _____

COMPLETED

SW SE SE

_____ Ft. from N. Line

330 Ft. from S. Line990 Ft. from E. Line

_____ Ft. from W. Line

SECTION PLAT

			0.

Location _____

Rig up _____

Drilling and Remarks:

*2000 acid**Pot - 1195***RECORD**Cased 7 in., 3397 ft.Sand 511 - 3397

Gas _____

Oil _____

Total Depth 3416**PRODUCTION**

1st 24 hrs. Nat. _____

1st 24 hrs. after shot _____

Gas _____ Cu. Ft.

Dry Hole _____

Abandoned _____

Date

SEP 29 1937

19

H. D. Hatfield

Scout