

Sec. 16 Twp. 11 R. 15W

Well No. #2 Howe Farm

Stearns Oil Company


Fairport Pool

990' Ft. from N. Line

_____ Ft. from S. Line

_____ Ft. from E. Line

330' Ft. from W. Line

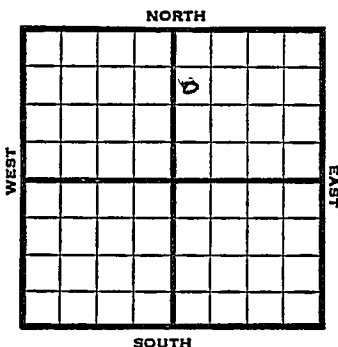

SW NW NE

1949 Elev. 1941' REPORT

- 4/13 RUR
- 4/20 8"@ 250'
Drlg 2000'
- 4/27 Lansing 3063'
Arb. 3383'
TD 3401'
5"@ 3396'
- 5/4 "
- 5/10 Swb 1½ bbls oil PH 8 hrs.
- 5/18 24 shots 3393-97
1000 acid
SO&W
- 5/25 PB
- 6/1 "
- 6/7 TD 3401'
- 6/15 "
- 6/21 3407' Drlg
- 6/28 Drlg 3418'
- 7/6 "
- 7/12 SD
- 7/20 Drlg 3443'
- 7/27 TD 3448'
- 8/3 4"@ 3448'
- 8/10 "
- 8/17 12 shots 3427-31
500 acid
- 8/24 "

OVER

Map No. _____ Sec. 16 Twp. 11 R. 15W

Well No. 2 Howe

Stearns Oil Company

FIRST REPORT Contractor

SW NW NE

SECTION PLAT

990 Ft. from N. Line

_____ Ft. from S. Line

_____ Ft. from E. Line

330 Ft. from W. Line

		o	

Russell County

Location _____

Rig up _____

Drilling and Remarks:

R U R

RECORD

Cased _____ in., _____ ft.

Sand _____

Gas _____

Oil _____

Total Depth _____

PRODUCTION

1st 24 hrs. Nat. _____

1st 24 hrs. after shot _____

Gas _____ Cu. Ft.

Dry Hole _____

Abandoned _____

Date

APR 13 1949

19-

S. J. LEWIS Scout

Map No. A 72 Sec. 16 Twp. 11 R. 15W

Well No. 2 Howe

Stearns Oil Company

COMPLETE

Contractor

SW NW NE

E. 1941

SECTION PLAT

990 Ft. from N. Line

_____ Ft. from S. Line

_____ Ft. from E. Line

330 Ft. from W. Line

Russell County

Location _____

Rig up _____

Drilling and Remarks:

Lease 3063
Cr X 3393
15000 cu ft
Pump 180 oil + 5W
PT
382 cu

RECORD

Cased _____ in., _____ ft.

Sand _____

Gas _____

Oil _____

Total Depth 3448

PRODUCTION

1st 24 hrs. Nat. _____

1st 24 hrs. after shot _____

Gas _____ Cu. Ft.

Dry Hole _____

Abandoned _____

Date

SEP 7 1949 19

S. J. LEWIS Scout

1949

8/31 12 cone shots 3427-31-500 acid

9/7 Lāns" 3063'

Arb 3393'

1500 acid

Pump 18 oil & 5 W Pot.

Grav. 38°

TD 3448'

COMPLETED