

Russell


KANSAS

SECTION 16 TOWNSHIP 11 RANGE 15W

WELL NO. #5 Hines "B"

COMPANY Sohio

NORTH SE SE NW

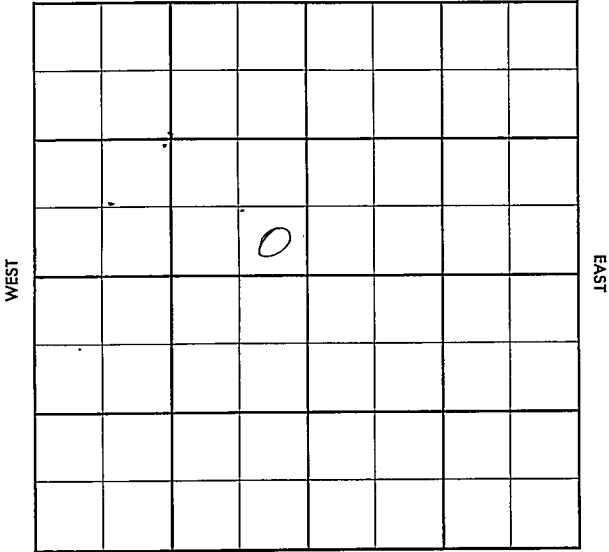

SOUTH


County Russell Elev. \_\_\_\_\_  
 Sec. 16 Twp. 11 Rge. 15W  
 Company Sohio  
 Farm Name Hines "B" No. 5

TOPS	DEPTH	LOG	DATUM
Anh.	1007		
TP.			
H.			
Tr.			
Dg.			
Bl.			
L.			
K.C.			
B.K.C.			
Ce.			
C.			
M.			
M.			
K.			
Mz.			
Mo.			
V.			
S.			
S.			
A.			
R.			
PE.			
G.			
T.D.			

Loc. in Sec. \_\_\_\_\_  
SE SE NW  
 Geol. \_\_\_\_\_  
 Contr. \_\_\_\_\_  
Bennett &  
Pool Roberts  
Fairport

FIRST REPORT	
0	
JAN 30 1957	

Date Comm. 1-23-57  
8" @ 1019 drlg. 2375

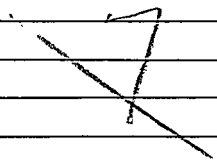

Co.  
 Use.  
 No.  
 Sec.  
 T.  
 R.

County Russell Elev. \_\_\_\_\_  
 Sec. 16 Twp. 11 Rge. 15W  
 Company Sohio  
 FarmName Hines "B" No. 5

TOPS	DEPTH	LOG	DATUM
Anh.	1007		
TP.			
H.			
Tr.			
Dg.			
Bl.			
L.			
K.C.			
B.K.C.			
Ce.			
C.			
M.			
M.			
K.			
Mz.			
Me.			
V.			
S.			
S.			
A.			
R.			
PE.			
G.			
T.D.			

Loc. in Sec. \_\_\_\_\_

SE SE NW

Geol. \_\_\_\_\_

Contr. \_\_\_\_\_

B & R Drlg.

Pool \_\_\_\_\_

Fairport

FIRST	REPORT
0	
JAN 30	57

Date Comm. 1-23-57

8" @ 1019 drlg. 2375

7

Co.

Use.

No.

Sec.

T.

R.

County Russell Elev. 1926  
 Sec. 16 Twp. 11 Rgs. 15W  
 Company Sohio  
 Farm Name Hines "B" No. 5

TOPS	DEPTH	LOG	DATUM	Loc. in Sec.
Anb.	1007			SE SE NW
Tp.	2742			
H.	2992			
Tr.	3012			
Dg.				Geol. _____ Contr. _____ Bennett & Pool Roberts Fairport
Bl.				
L.	3040			
K.C.				
B.K.L.	3302			
Ce.				
C.				
M.				
M.				
K.				
Mz.				COMPLETE o FEB 20 '57
Me.				
V.				
S.				
S.				
A.	3364			
R.				
Pe.				
G.				
TD.	3377			

Date Comm. 1-23-57

8" @ 1019 drlg. 2375 FEB 5 '57

DST 3108-38 1 hr 510' MSW  
FP 0-215 BHP 265/20" 5/2  
@ 3367/100 FEB 13 '57 CO 3377  
tst 25 GFPH 790 wtr 1/2  
\$ 1.16 BFPH 540 wtr 5 hr 12  
\$ 2.23 BFPH 1200 wtr DD  
3384 ft \$ 2.23 BFPH 2090  
wtr 28 hrs) FEB 20 '57 P.O.P. P. 25  
Bopt 7 20% wtr.