


Section 16 Township 11 Range 15W

Well No. #3 Howe

Company Stearns Pet.

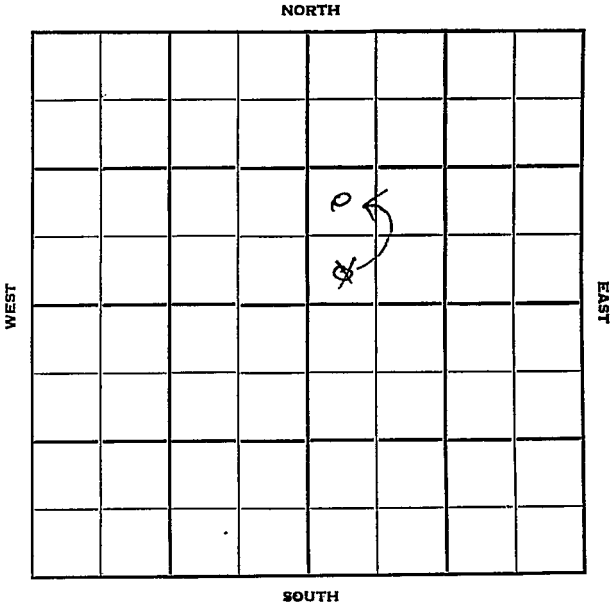

Sec. 16 Twp. 11 R. 7 15 W

Well No. # 3 Howe Farm

Stearns Pet. Company


Fairport Contractor

           Ft. from N. Line

990  
330 Ft. from S. Line

           Ft. from E. Line

330 Ft. from W. Line

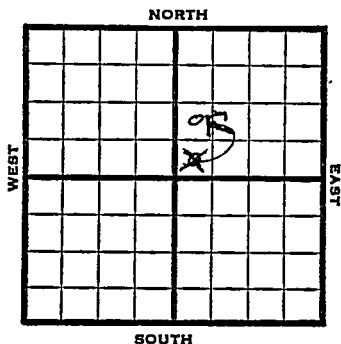

~~SW SW NE~~  
NW SW NE

1952 Elev. 1956' REPORT

1/30	Location
2/6	"
2/13	"
2/20	C & P
3/5	"
3/12	"
3/19	RUR
3/25	8" @ 200'
	Anhy 1039
	Drilg. 2668'
4/1	Heeb. 3027      Lans. 3075
	DST 3265-77, 45 mins. 37' OCM
	Arb. 3404
	DST 3406-16, 45 mins. 20' HOCM
	800# 15" RTD 3454
	5" @ 3454 WOCT
4/9	DP 500 A S/ 4 boph & SS wtr.
4/16	Spud 3-20-52
	Oil well TD 3454' 8" @ 200
	Anhy 1039' Heeb 3027' Lans. 3075'
	DST 3265-77 open 45 min, rec 37' OCM
	Arb. 3404'
	DST 3406-16 open 45 min, rec 20' HOCM
	TD 3454' 5" @ 3454' 11/3412-18
	500 A S/4 BOPH
	Comp. 25 BOPD

COMPLETED



Map No. \_\_\_\_\_ Sec. 16 Twp. 11 R. 15W

Well No. 3 Howe

Stearns Pet. Company

~~CORRECTION~~ Contractor

NW SW NE

SECTION PLAT

\_\_\_\_\_ Ft. from N. Line

990 Ft. from S. Line

\_\_\_\_\_ Ft. from E. Line

330 Ft. from W. Line

		o	

Russell County

Location \_\_\_\_\_

Rig up \_\_\_\_\_

Drilling and Remarks:

Reported

SW SW NE

RECORD

Cased \_\_\_\_\_ in., \_\_\_\_\_ ft.

Sand \_\_\_\_\_

Gas \_\_\_\_\_

Oil \_\_\_\_\_

Total Depth \_\_\_\_\_

PRODUCTION

1st 24 hrs. Nat. \_\_\_\_\_

1st 24 hrs. after shot \_\_\_\_\_

Gas \_\_\_\_\_ Cu. Ft.

Dry Hole \_\_\_\_\_

Abandoned \_\_\_\_\_

Date

MAR 19 1952 19

J. G. MCGEHEE

Scout

