


Russell

KANSAS

SECTION 16 TOWNSHIP 11S RANGE 15W

WELL NO. #1 Howe "A"

COMPANY Okmar Oil

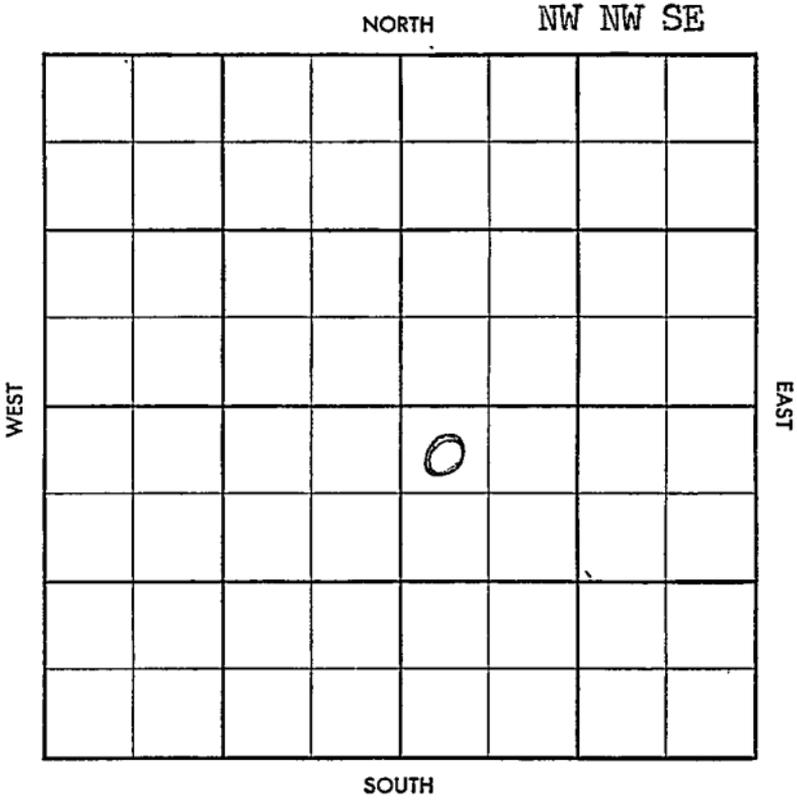

CO. ~~Russell~~ ELEV. ~~19290~~ EST.
 SEC. 16 TWP. 11 RGE. 15¹¹
 COMPANY ~~Oklahoma~~ Oil NO. 1

COMPLETE
 DEC 8 57

FARM Howe "A"

LOC. NE 1/4 SW 3/4

GEOL. _____
 CONTR. Leben Trl.
 POOL Fairport
 SPUD 11-22-57
 Location NO. 2
11-27-57

Ø 1615 DEC 4 57
85 2061150
Anhoco Hb
3000 L 3049

DST 3032-65 60" 75' 089cm
BHP 155 DST 3235-65
60" 35 US to GCM BHP 245
DST 3255-85 60" 45'
Dcm BHP 190 art 3377
TD 3380 5 1/2" 3378 woc
CO DD 3390 TD
P/B 3050 20/ 3010 24
21 No test P/B
2.5.30 dd NW TR 3018-23

CO.
 LSE.
 NO.
 SEC.
 TWP.
 RGE.