


Russell

Form 51-5M-11-31-Palace

Map No. **KANSAS** Sec. 16 Twp. 11 R. 15W

Well No. 1 1/2 Hiteon Farm
Pat Ashby Company

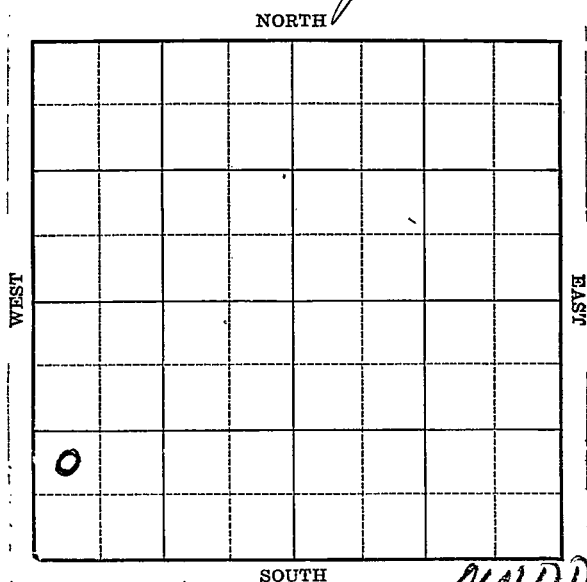

Location _____

Drilling Remarks _____

Rig Up _____

Drilling Remarks _____

RECORD

Cased _____ in. _____ ft.

Sand _____

Gas _____

Oil _____

Total Depth _____

PRODUCTION

1st 24 hrs. Nat. _____

1st 24 hrs. after shot _____

Gas _____ cu. ft.

Dry Hole _____

Abandoned _____

Russell

Map No. KANSAS Sec. 16 Twp 11 R. 15 W

Well No. 1 Whitson Farm


Pat Ashby Company

 Ft. from N. Line

990 Ft. from S. Line

 Ft. from E. Line

330 Ft. from W. Line

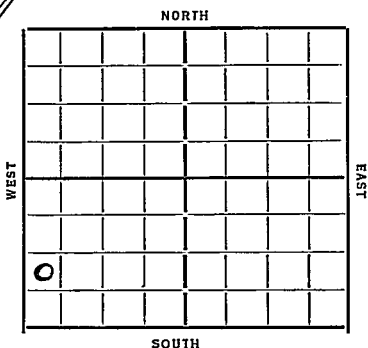

Date 7/9/34

REPORT

OW 111

4/18 Machine Dlg 448
4/26
5/3 Dlg 1440
5/10 " 2090
5/18 2170 Re bldg rig
5/25 Dlg 2330
5/31 6" 2418 TD 2460 NR 6"
6/7 Dlg 2528 6" 2488
6/14 " 2604
6/31 NR 6" 2705
6/28 6 7/8 2695 Long 2960
Oswald 2980 Run 5"
7/5 9 4/7 2984 Run 5" 3065
7/12
7/19 5" 3128 7 1/2 3134
7/26 Pay 3160-65 About 10 Bbls
per hr.
8/2 1000 acid
8/9 Testing
8/16 Pump 523 Bbls 24 hrs.
8/22 Oswald 2980 Oil 3160-65
TD 3165 1000 acid 540 oil 16 water

COMPLETED

OVER

KANSAS

Map No. 72 Sec. 16 Twp. 11 R. 15WWell No. 1-WhitsonPat Ashby Company

Contractor

FIRST REPORT

SECTION PLAT

0			

 Ft. from N. Line990 Ft. from S. Line Ft. from E. Line330 Ft. from W. LineLocation Rig up

Drilling and Remarks:

machineWeg 448

RECORD

Cased in., ft.Sand Gas Oil Total Depth

PRODUCTION

1st 24 hrs. Nat. 1st 24 hrs. after shot Gas Cu. Ft.Dry Hole Abandoned

Date

4-18-34 19

ORVAL MANNSCHRECK

Scout

KANSAS

Map No. 72 Sec. 16 Twp. 11 R. 15WWell No. 1-WhitsonPat Ashby Company

Contractor

COMPLETED

SECTION PLAT

0			

____ Ft. from N. Line

990 Ft. from S. Line

____ Ft. from E. Line

330 Ft. from W. Line

Location _____

Rig up _____

Drilling and Remarks:

1000 acid540 oil
16 water

RECORD

Cased _____ in., _____ ft.

Sand Pat Ashby 2980

Gas _____

Oil 3160-65Total Depth 3165

PRODUCTION

1st 24 hrs. Nat. _____

1st 24 hrs. after shot _____

Gas _____ Cu. Ft.

Dry Hole _____

Abandoned _____

Date

8-22-31

19

J. AL MANNSCHRECK

Scout

KANSAS

Form 26-1M Bks-2-29

Map No. 72 Sec. 16 Twp. 11 R. 15WWell No. 1-WhitsonRat Ashby Company

Contractor

FIRST REPORTS SECTION PLAT

 Ft. from N. Line990 Ft. from S. Line Ft. from E. Line330 Ft. from W. Line

0			

Location Rig up

Drilling and Remarks:

OTN 3165Deepened to 3208pay 3204-08297 bbls nat.1000 oil

RECORD

Cased in., ft.Sand Gas Oil Total Depth

PRODUCTION

1st 24 hrs. Nat. 1st 24 hrs. after shot Gas Cu. Ft.Dry Hole Abandoned

Date

ORVAL MANNSCHRECK

11-14-34 19

Scout

Map No. 72 Sec. 16 Twp. 11 R. 15WWell No. 1-WhitsonAshby

Company

Contractor

~~COMPLETED~~

SECTION PLAT

0			

_____ Ft. from N. Line

990 Ft. from S. Line

_____ Ft. from E. Line

330 Ft. from W. LineOWN

Location _____

Rig up _____

Drilling and Remarks:

1000 acid402 bbls

RECORD

Cased _____ in., _____ ft.

Sand _____

Gas _____

Oil 3204-08Total Depth 3208

PRODUCTION

1st 24 hrs. Nat. _____

1st 24 hrs. after shot _____

Gas _____ Cu. Ft.

Dry Hole _____

Abandoned _____

Date

11-21-34 19ORVAL MANNSCHRECK
Scout

1934

OWD D

11/14 OT D 3165

Deepened to 3208

Pay 3204-08

297 Bbls Net

1000 acid

11/21 Oil 3204-08 T D 3208

1000 acid 402 Bbls.

COMPLETED